

# SUITE: 1010

# RSF: 3,020





## AS-BUILT CONFIGURATION

- OFFICES..... 1
- RECEPTION..... 1
- CONFERENCE ROOMS..... 2
- KITCHEN..... 1
- OPEN WORK AREA..... +/- 22

## KEY PLAN:

*Not to scale, furniture and appliances not included*

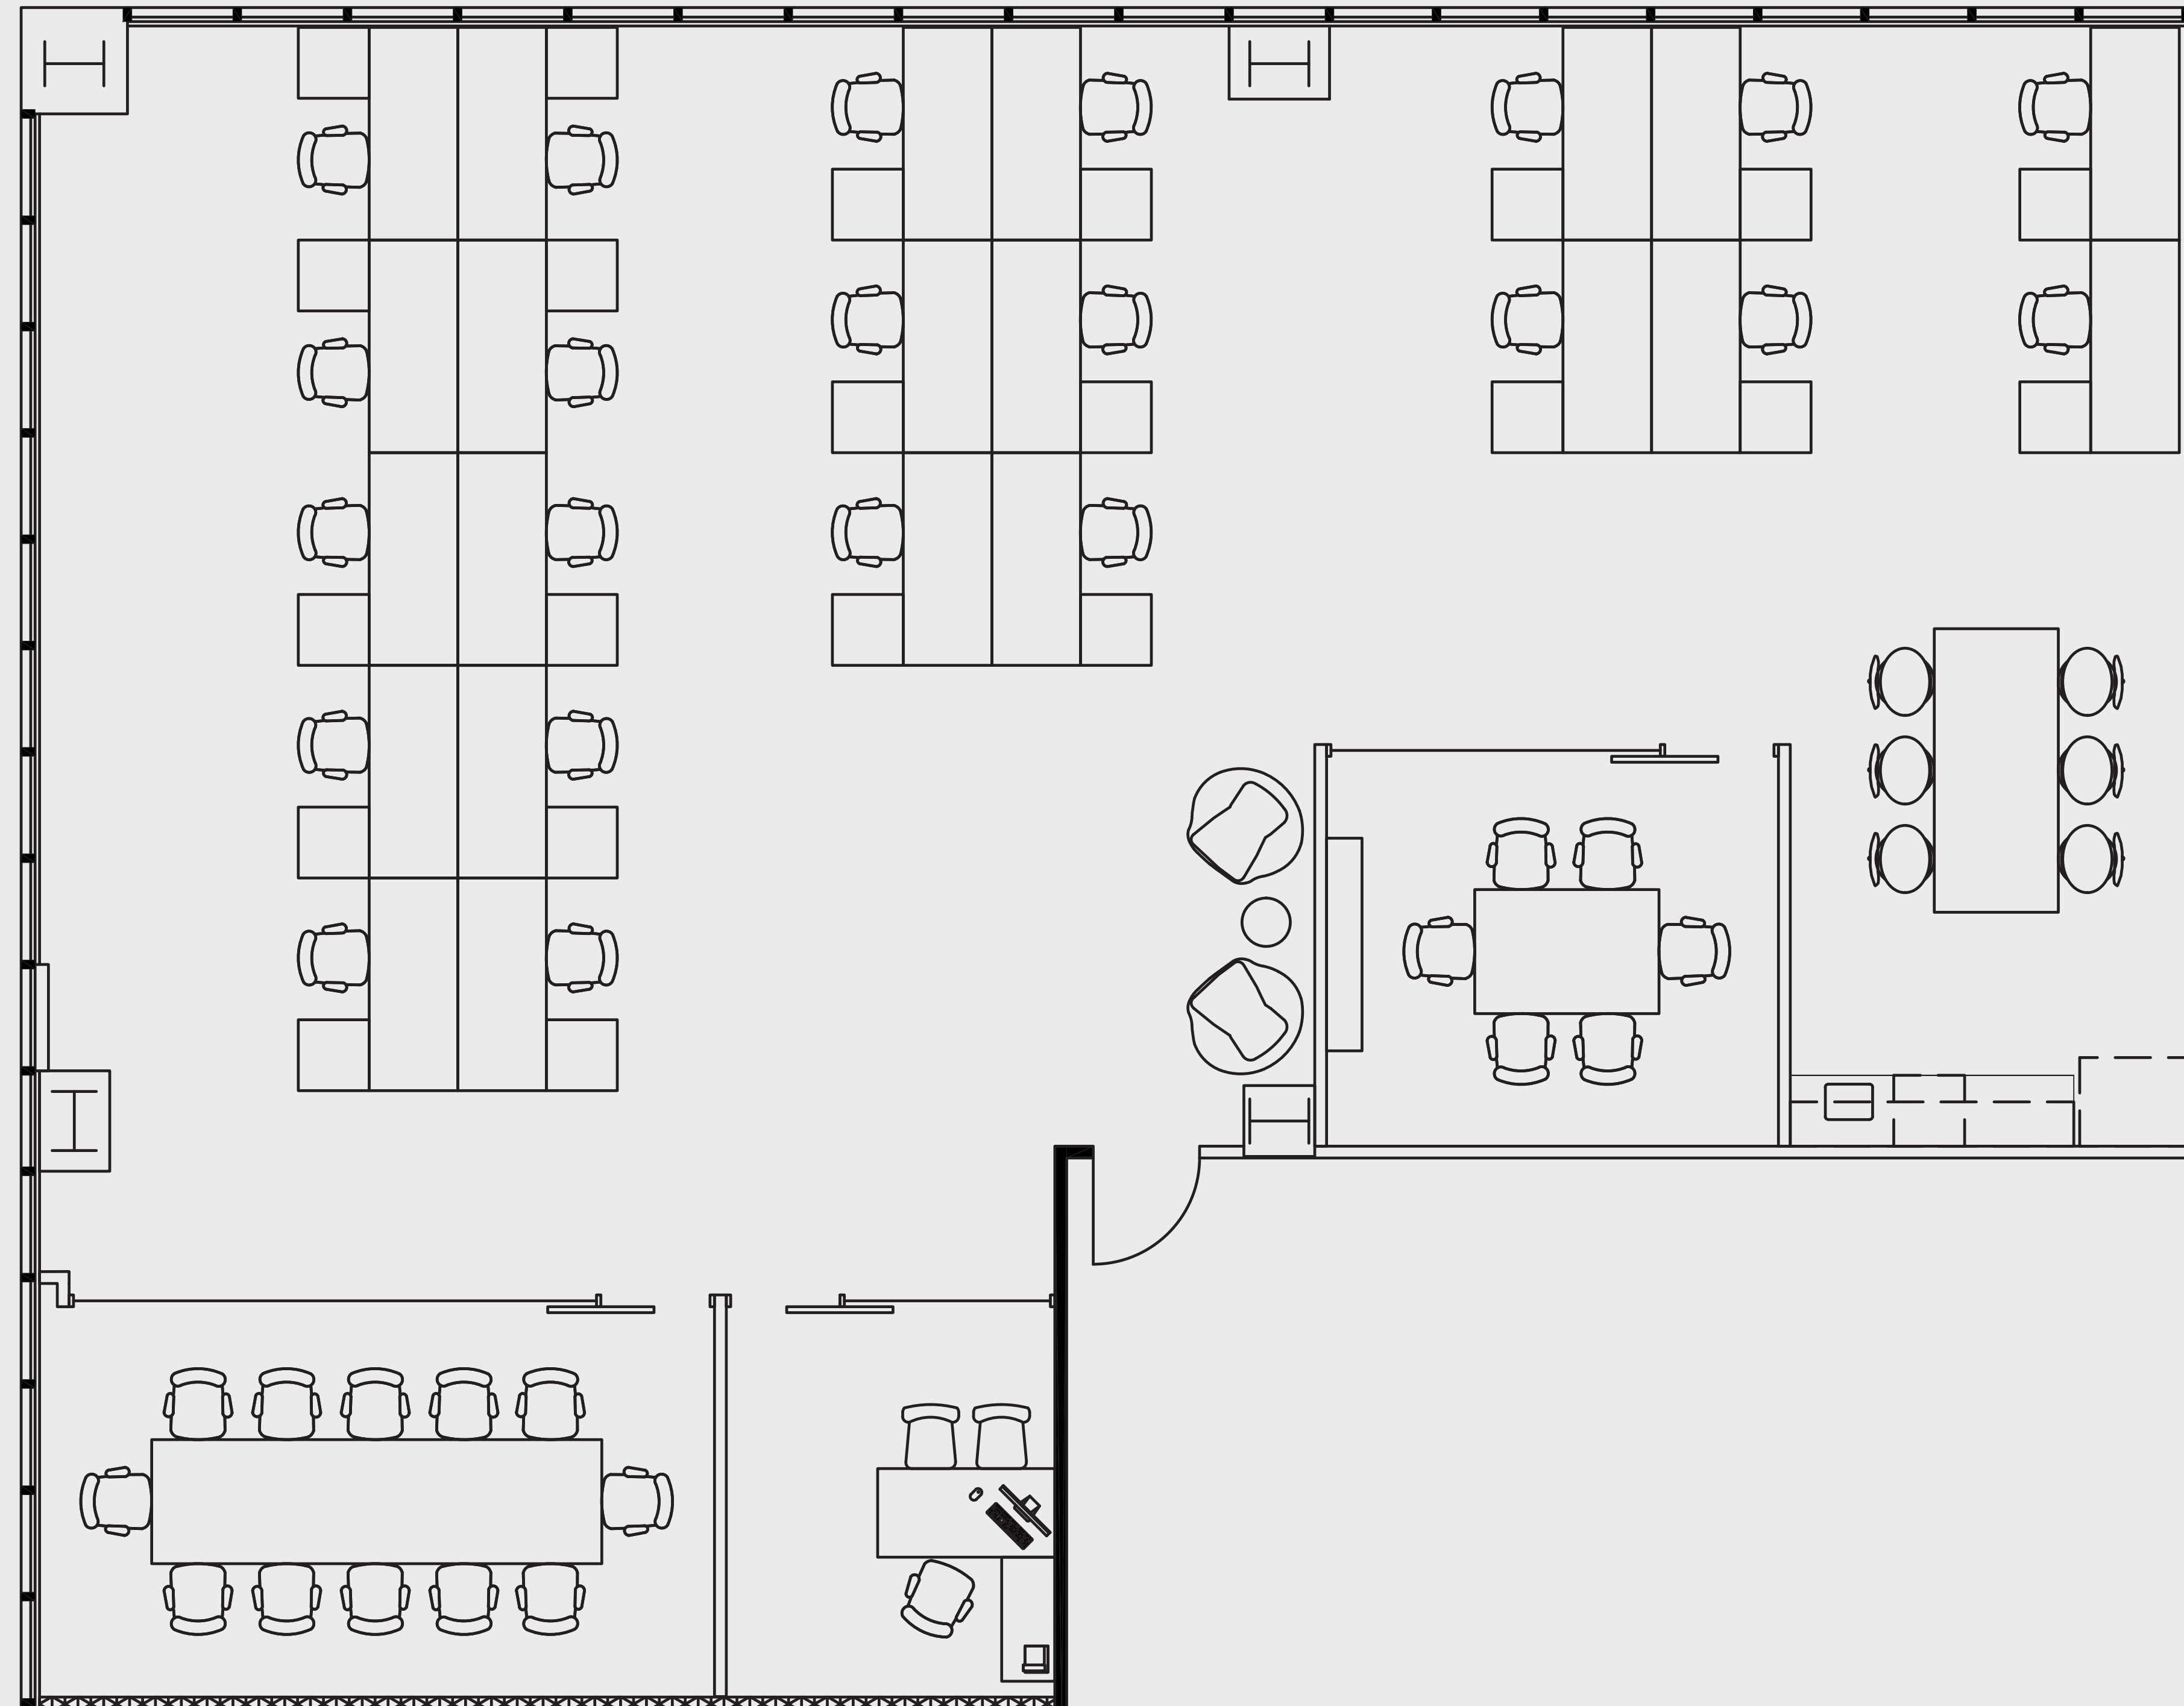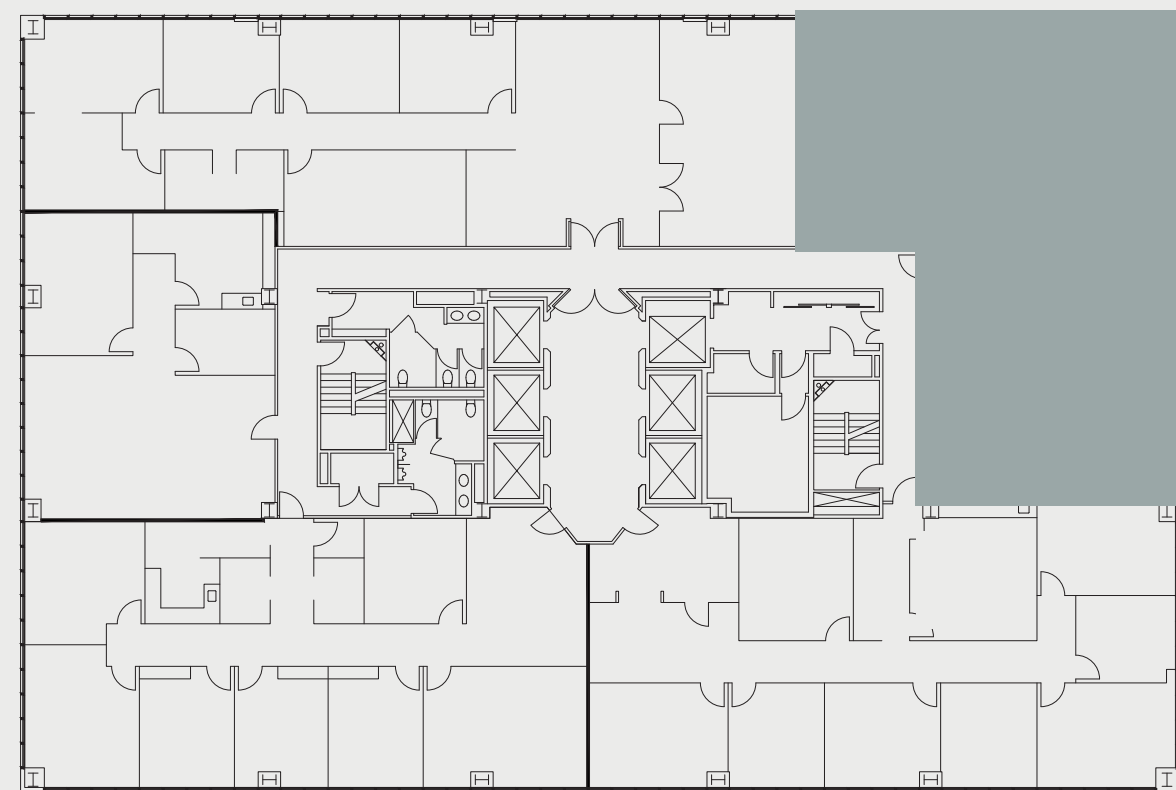

For leasing information please contact:

Nico Vilgiate  
213.532.3236 | nico.vilgiate@colliers.com

Nick Moscicki  
213.861.3345 | nick.moscicki@colliers.com

