

SUITE: 103

RSF: 2,891





AS-BUILT CONFIGURATION

- OFFICES..... N/A
- RECEPTION..... N/A
- CONFERENCE ROOMS..... N/A
- KITCHEN..... N/A
- OPEN WORK AREA..... N/A

KEY PLAN:

*Not to scale, furniture and appliances not included*

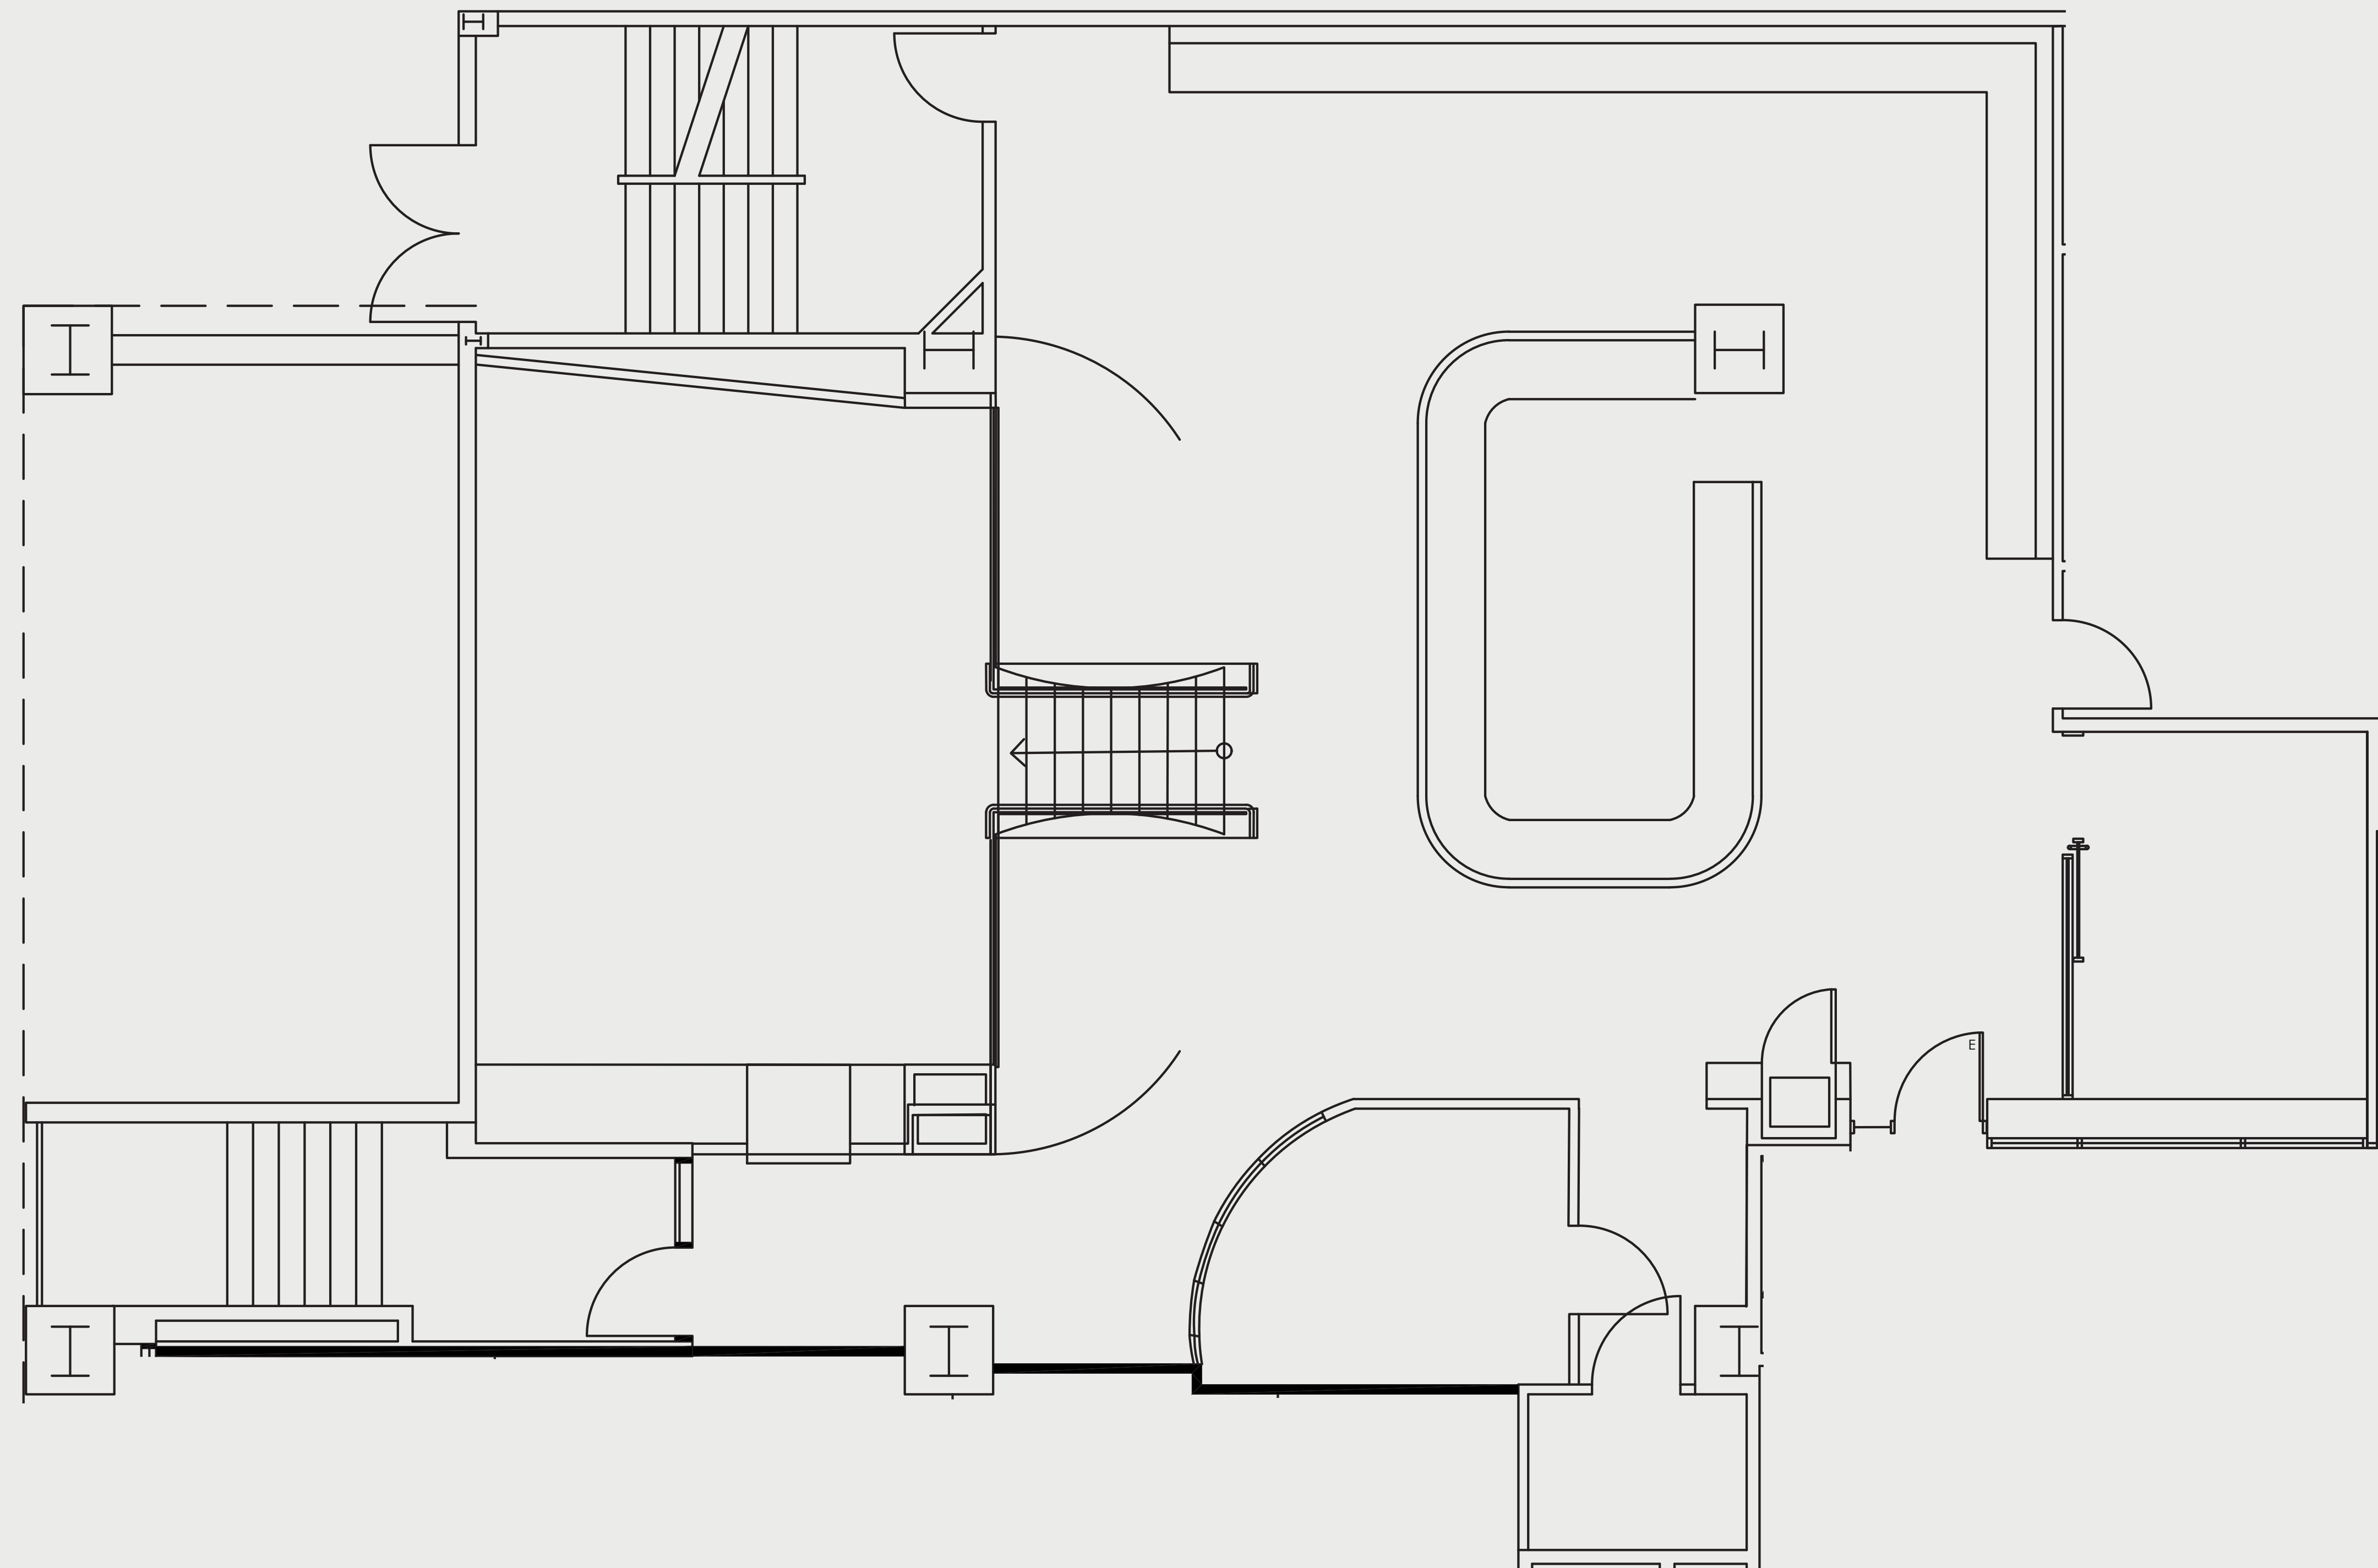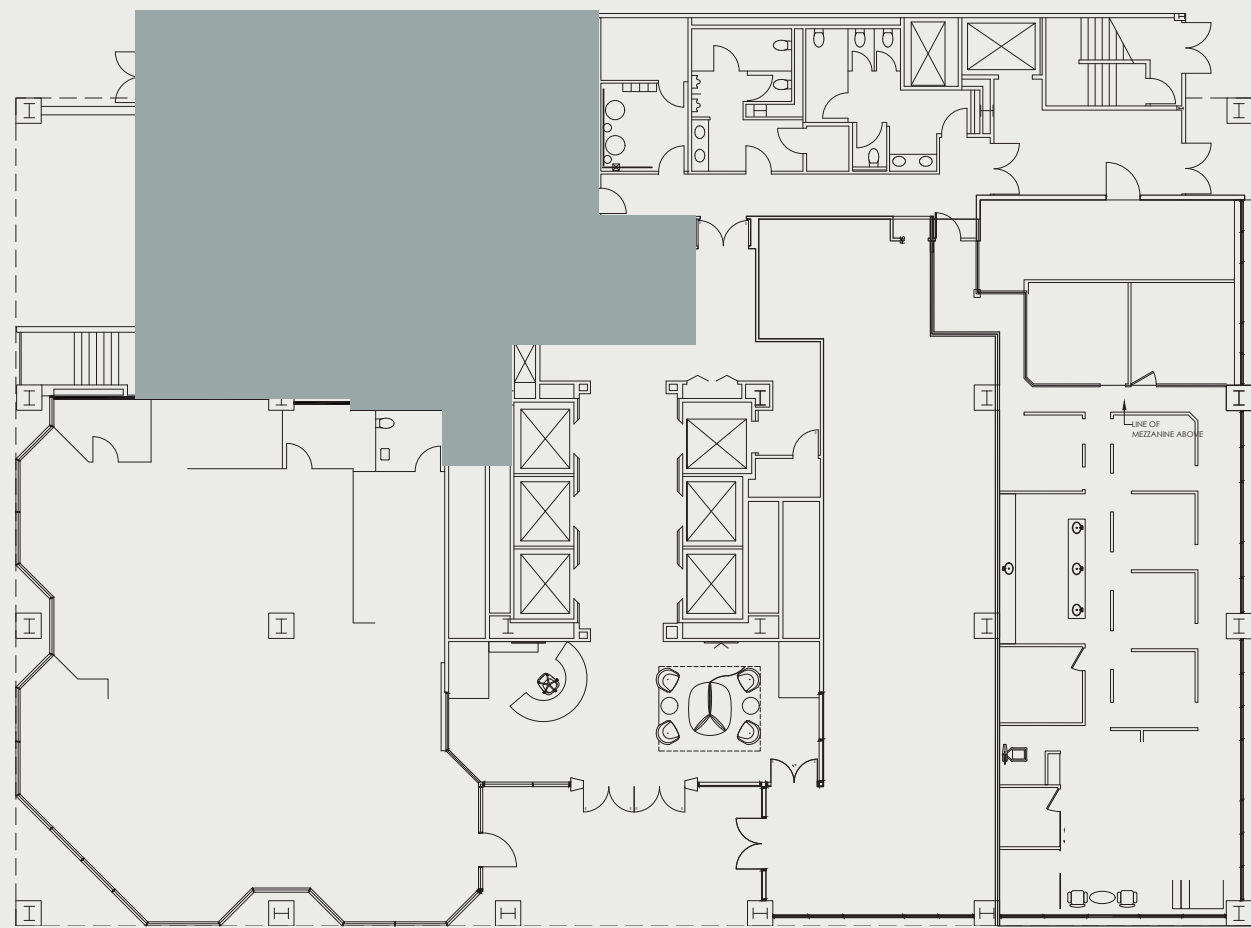

For leasing information please contact:

Nico Vilgate  
213.532.3236 | nico.vilgate@colliers.com

Nick Moscicki  
213.861.3345 | nick.moscicki@colliers.com

