

SUITE: 1400

RSF: 4,646



EIGHTHUNDREDWILSHIRE

AS-BUILT CONFIGURATION

OFFICES.....	12
RECEPTION.....	1
CONFERENCE ROOMS.....	1
KITCHEN.....	1
OPEN WORK AREA.....	+/- 2

Not to scale, furniture and appliances not included

KEY PLAN

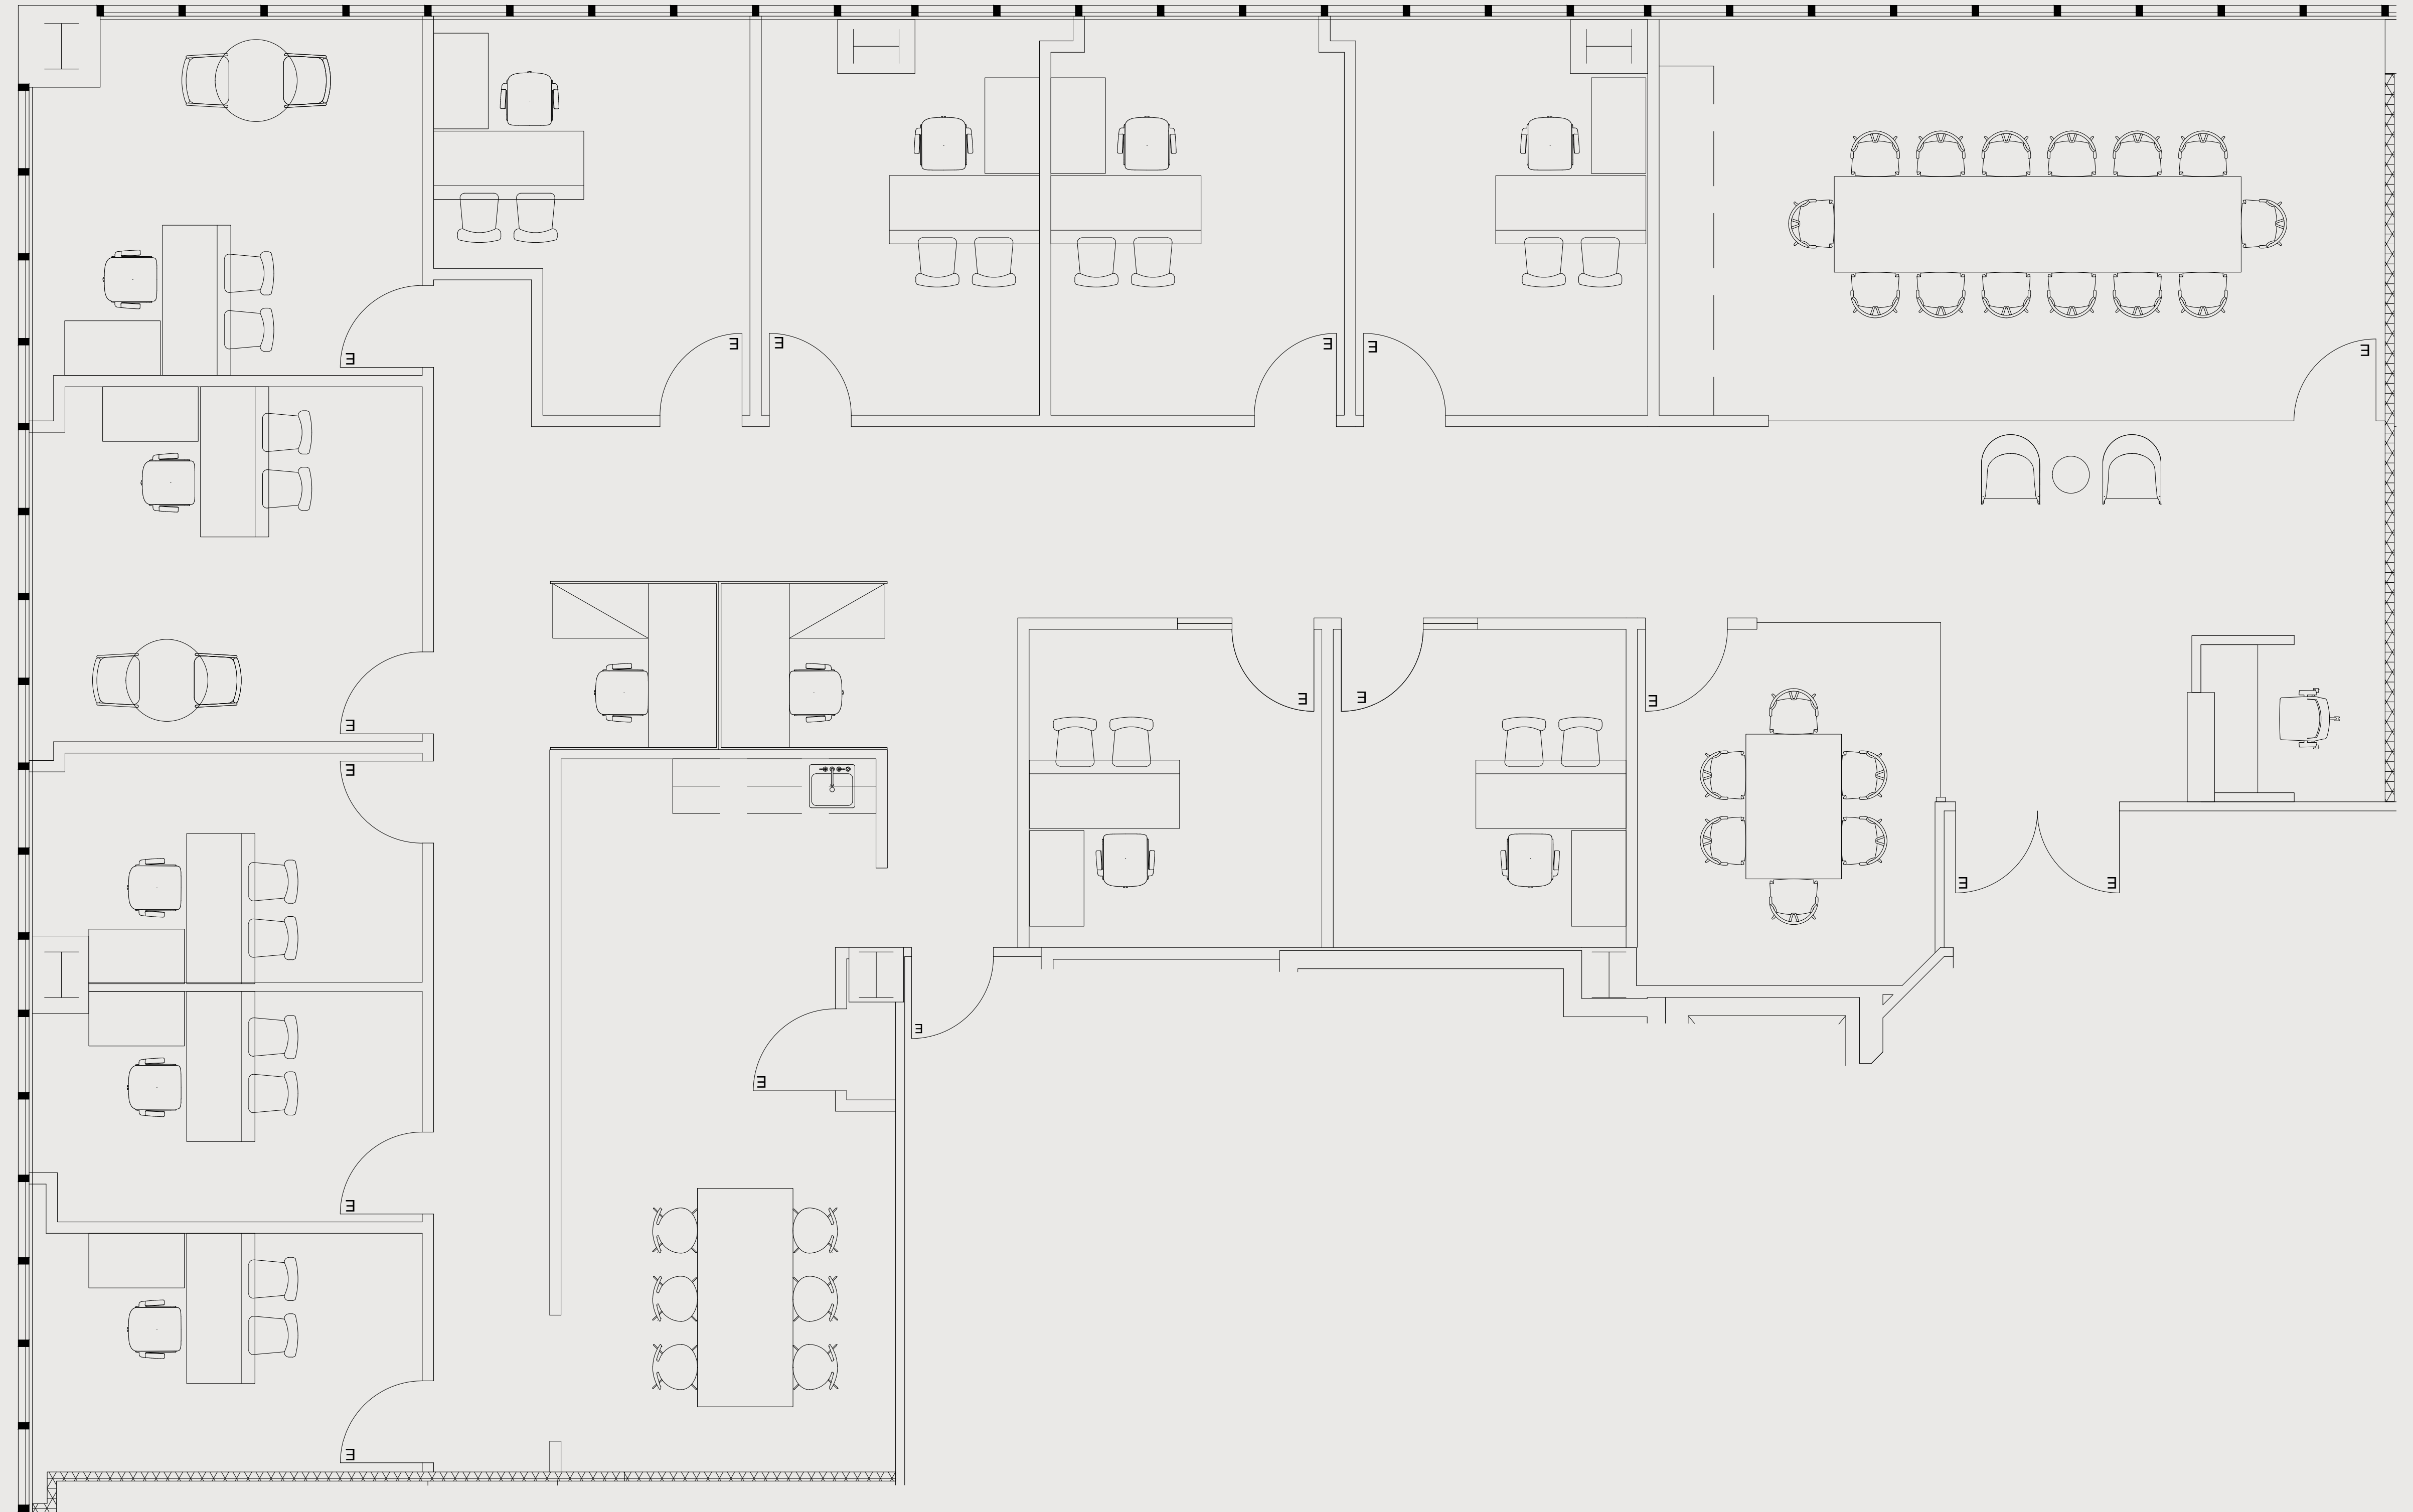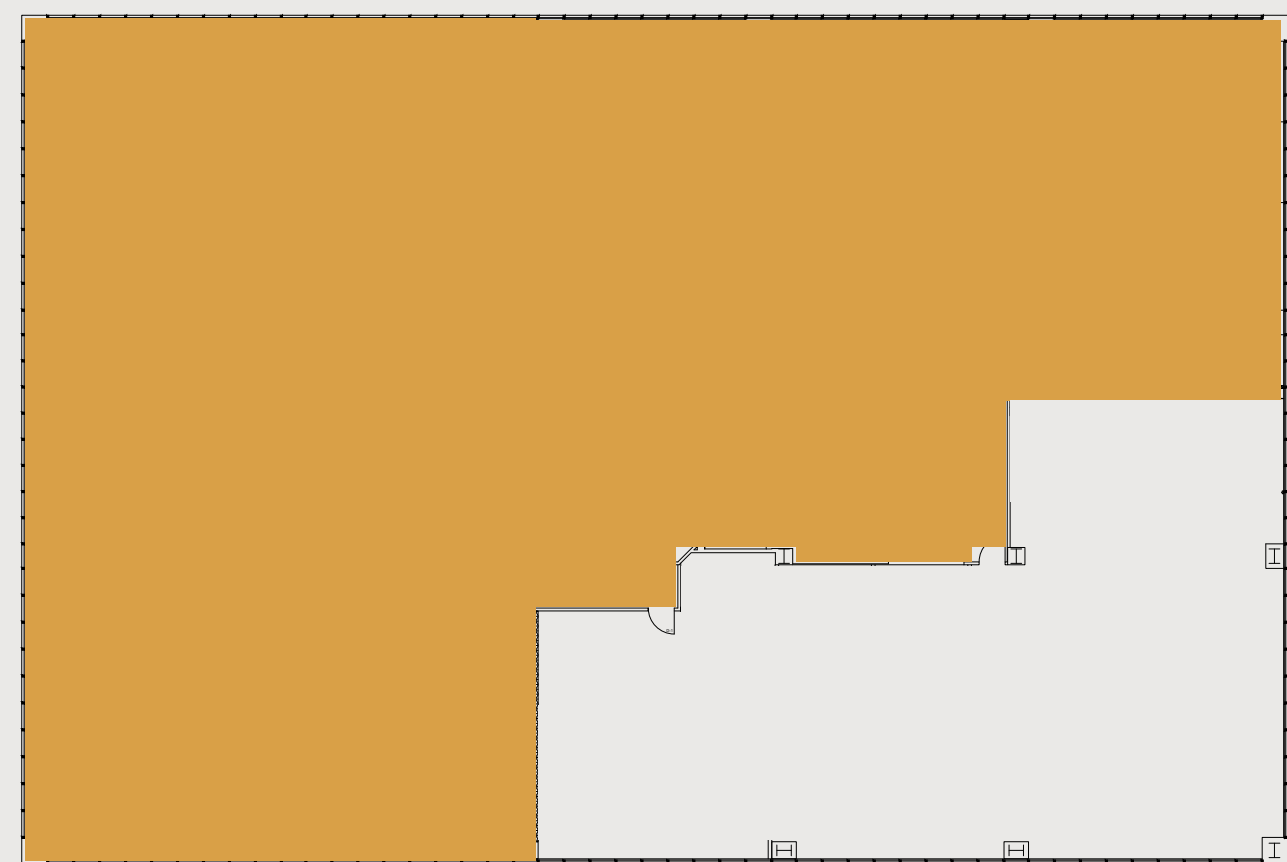

For leasing information please contact:
Andrew Tashjian
213.955.5148 andrew.tashjian@cushwake.com

