


SUITE: 1410 RSF: 6,643

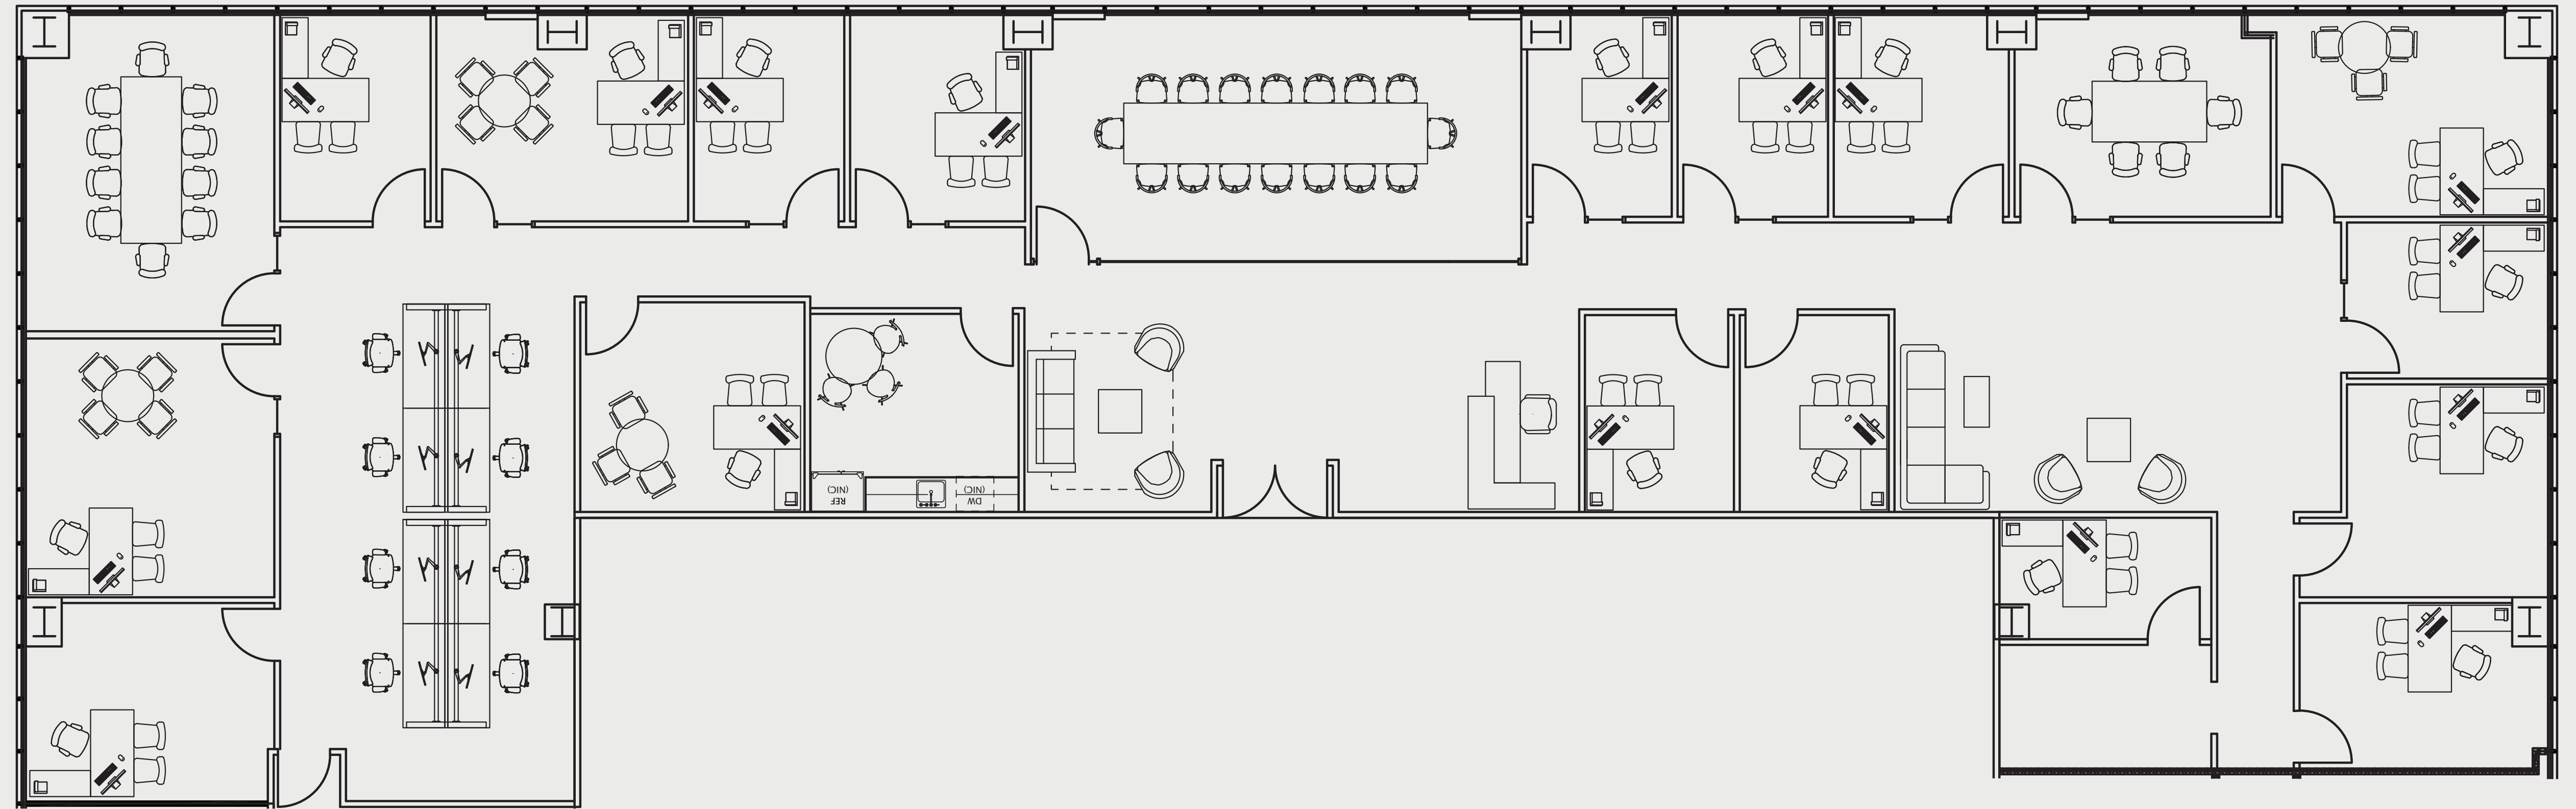


AS-BUILT CONFIGURATION

OFFICES.....	17
RECEPTION.....	1
CONFERENCE ROOMS.....	3
KITCHEN.....	1
OPEN WORK AREA.....	8



KEY PLAN:

Not to scale, furniture and appliances not included

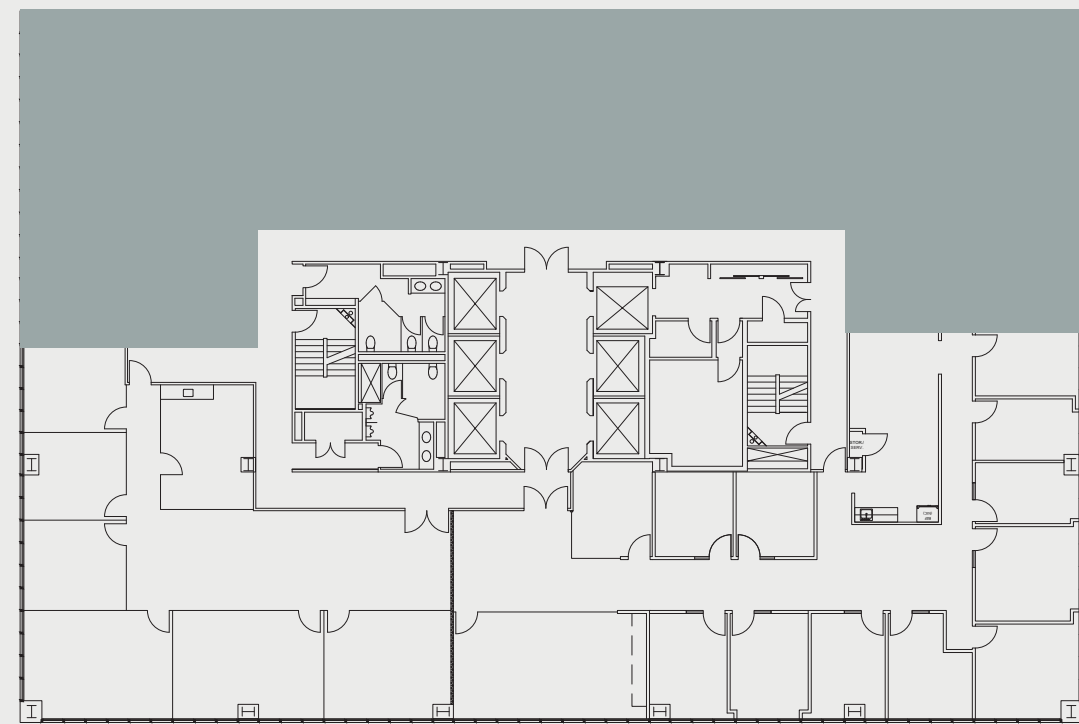

For leasing information please contact:

Nico Vilgate
213.532.3236 | nico.vilgate@colliers.com

Nick Moscicki
213.861.3345 | nick.moscicki@colliers.com

