

SUITE: 1450

RSF: 3,177





AS-BUILT CONFIGURATION

- RECEPTION..... 1
- PRIVATE OFFICES..... 4
- CONFERENCE ROOMS..... 2
- KITCHEN..... 1
- OPEN WORK AREA..... +/- 4

KEY PLAN:

Not to scale, furniture and appliances not included

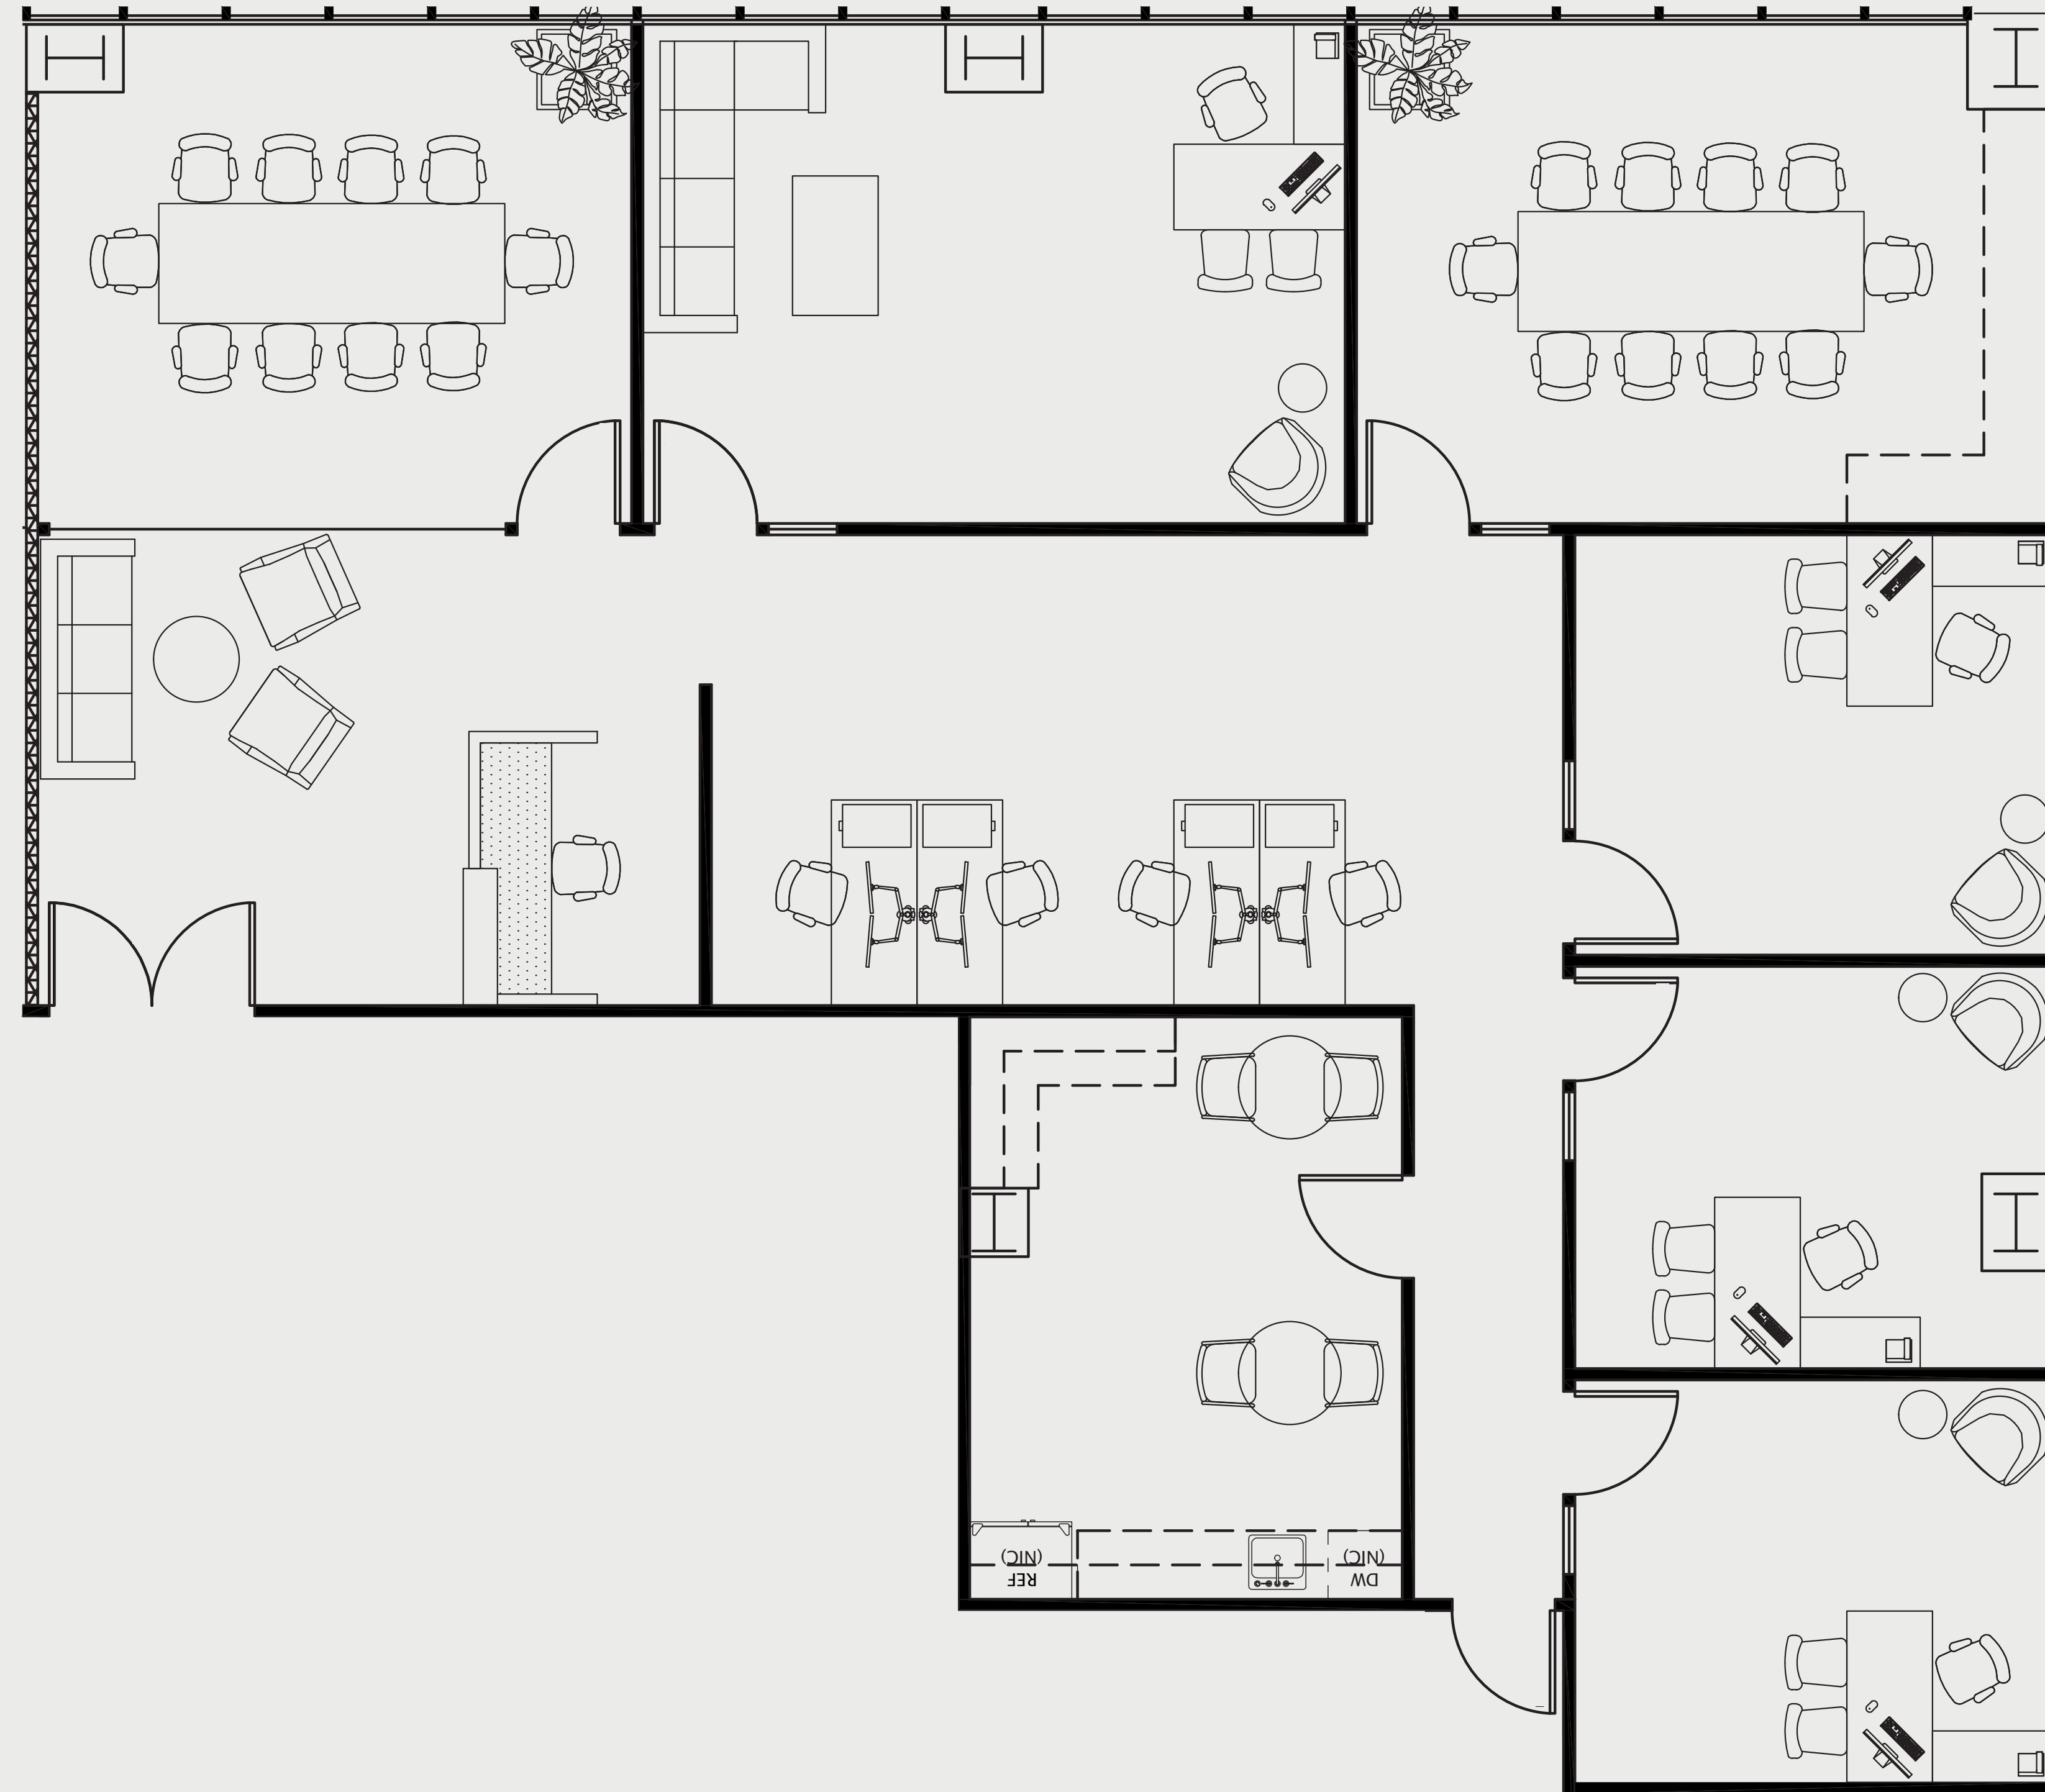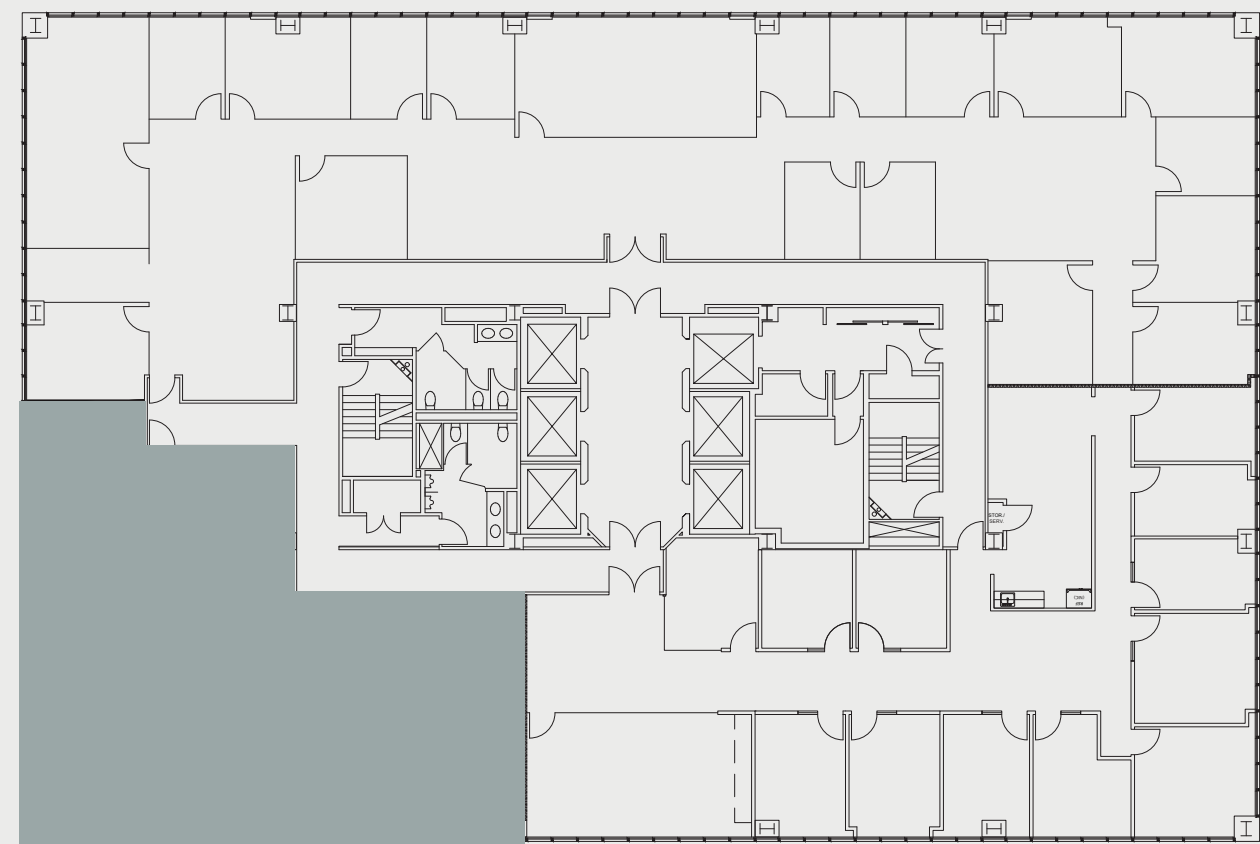

For leasing information please contact:
Nico Vilgate
213.532.3236 | nico.vilgate@colliers.com

Matthew Mazur
213.532.3203 | matthew.mazur@colliers.com

