

# SUITE: 1510

# RSF: 3,030





## AS-BUILT CONFIGURATION

- OFFICES..... 2
- RECEPTION..... 1
- CONFERENCE ROOMS..... 1
- KITCHEN..... 1
- OPEN WORK AREA..... +/- 10

*Not to scale, furniture and appliances not included*

## KEY PLAN

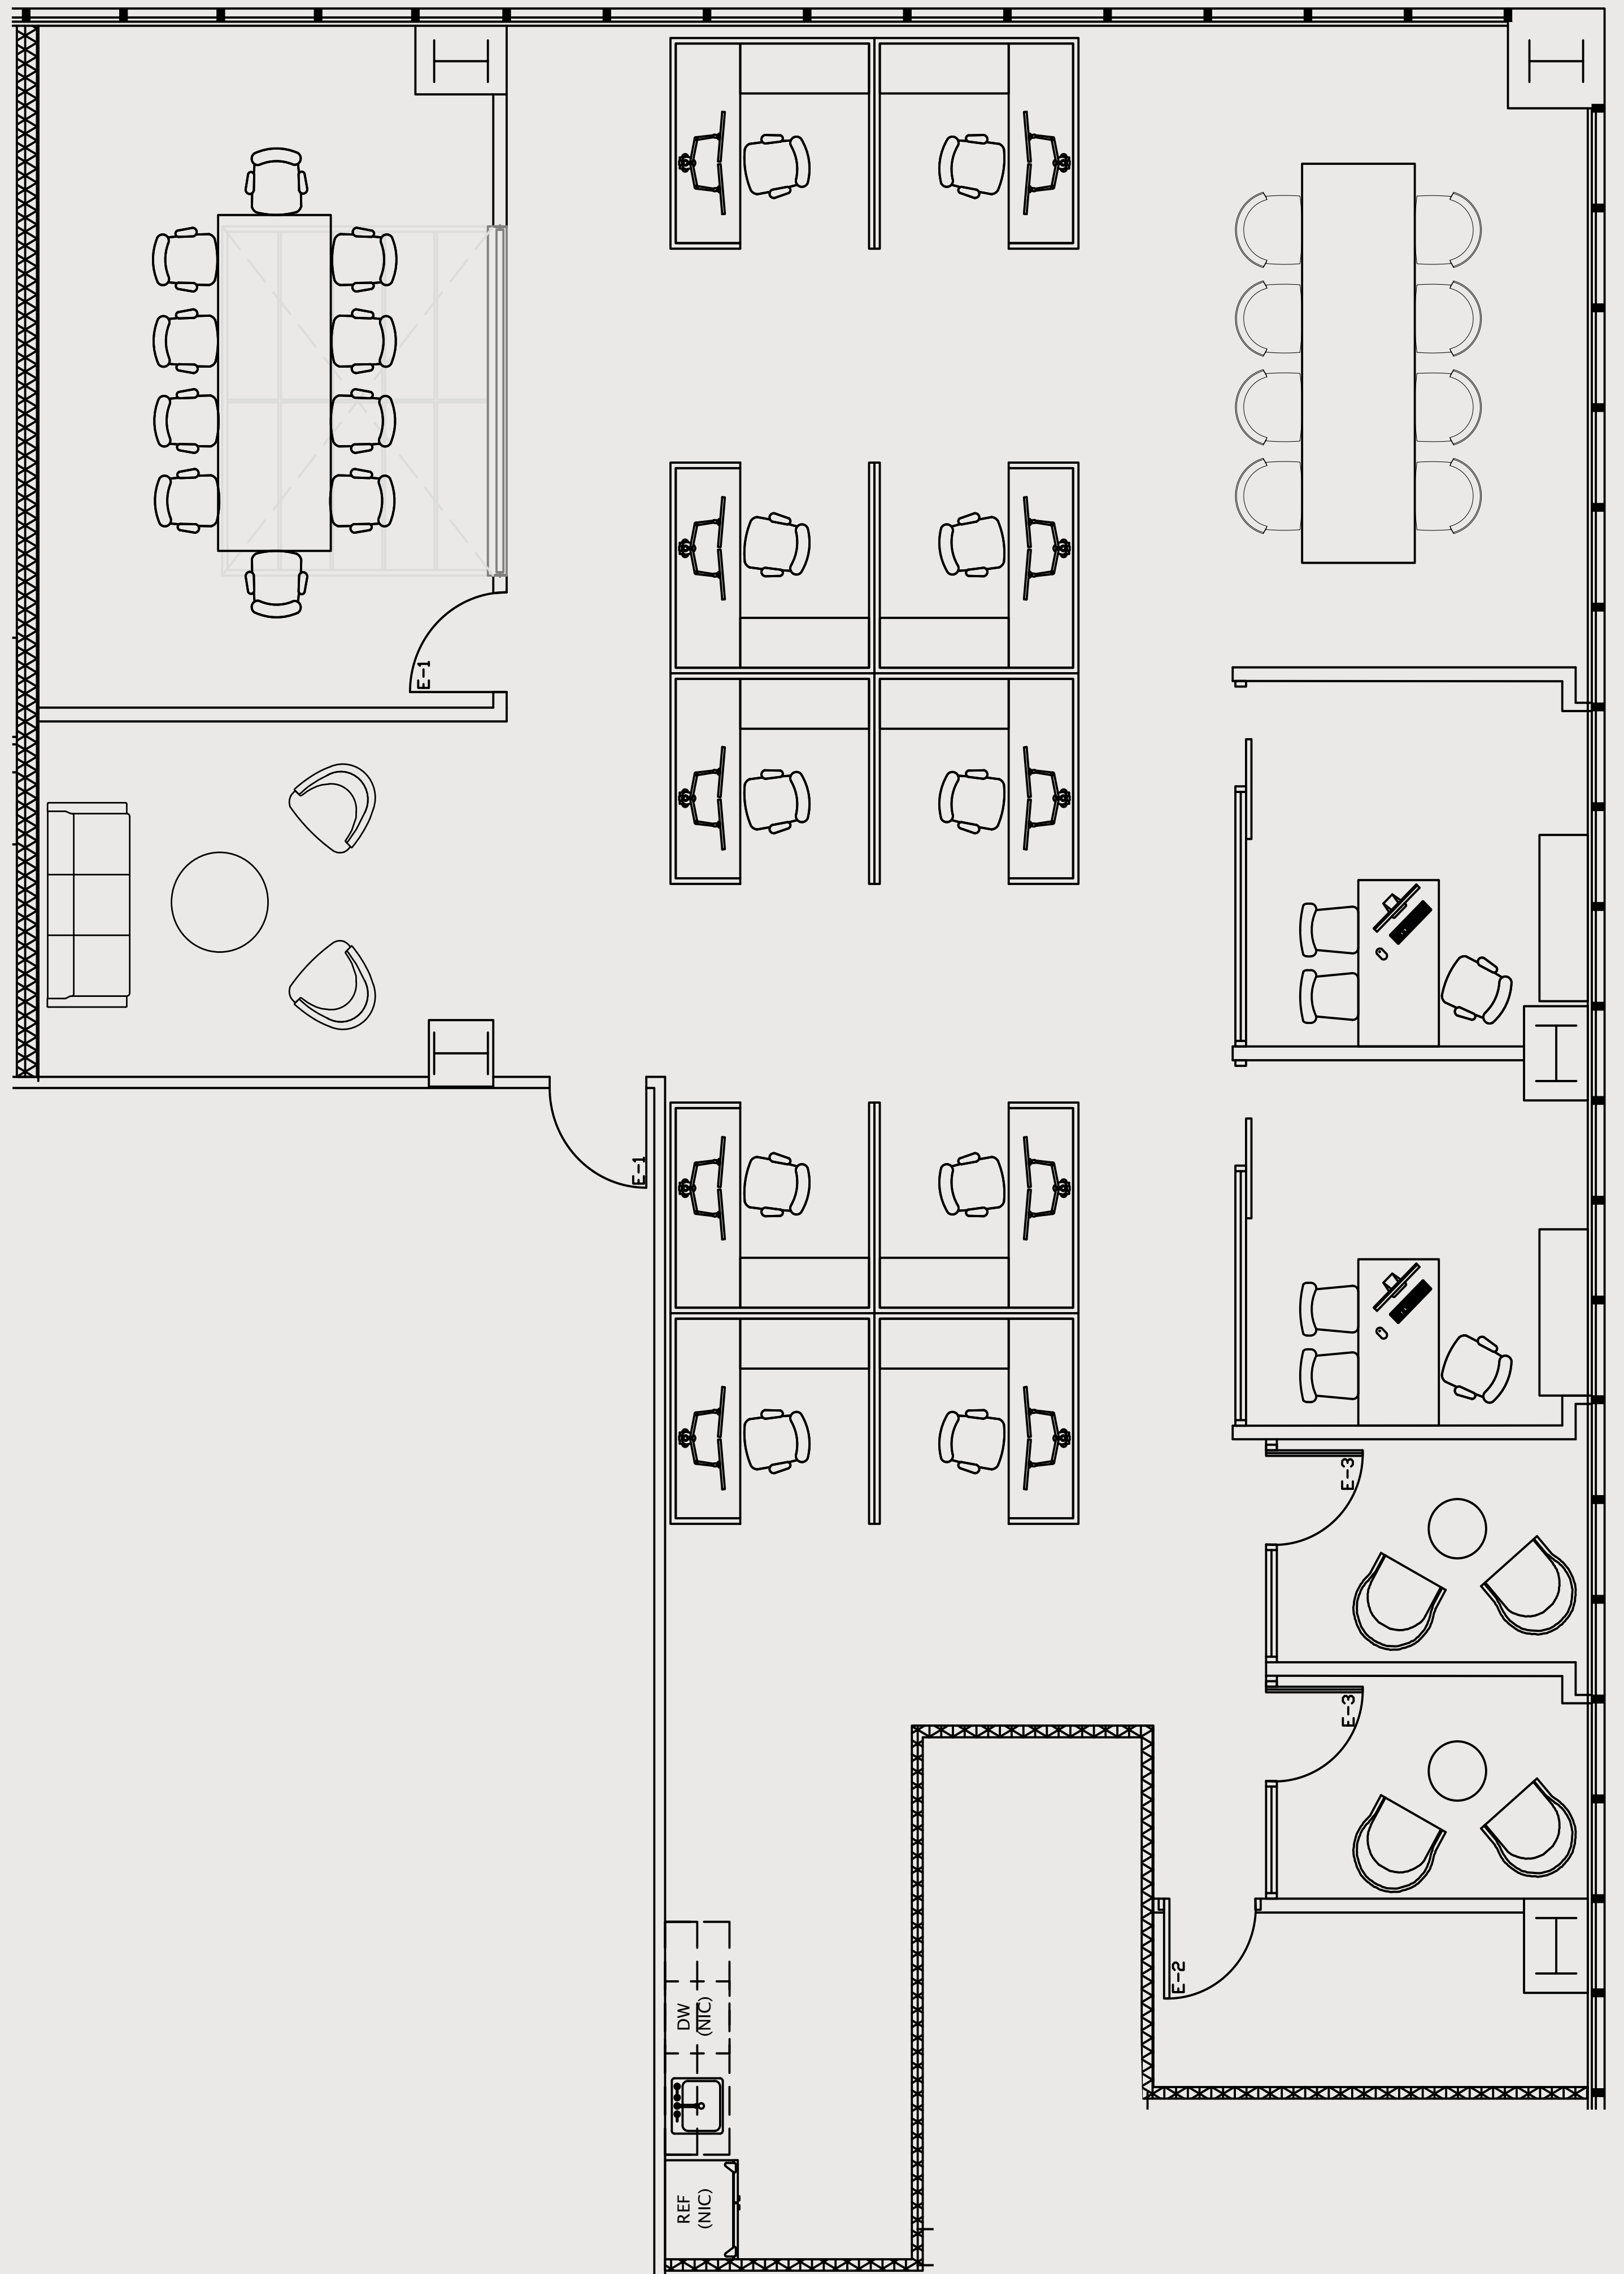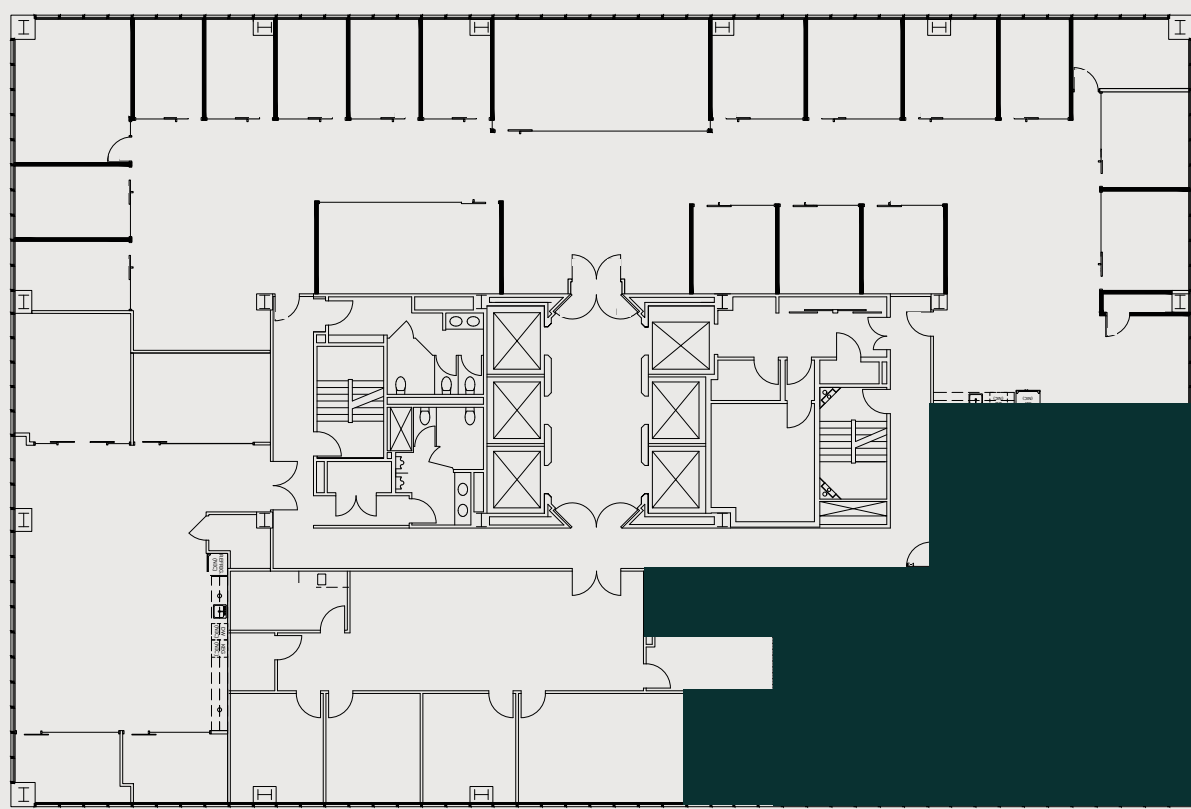

For leasing information please contact:  
USALEASING@ONNI.COM  
(213) 629-2041

