

SUITE: 200

RSF: 14,967





AS-BUILT CONFIGURATION

- OFFICES..... 3
- RECEPTION..... 1
- CONFERENCE ROOMS..... 5
- KITCHEN..... 1
- OPEN WORK AREA..... N/A

KEY PLAN:

*Not to scale, furniture and appliances not included*

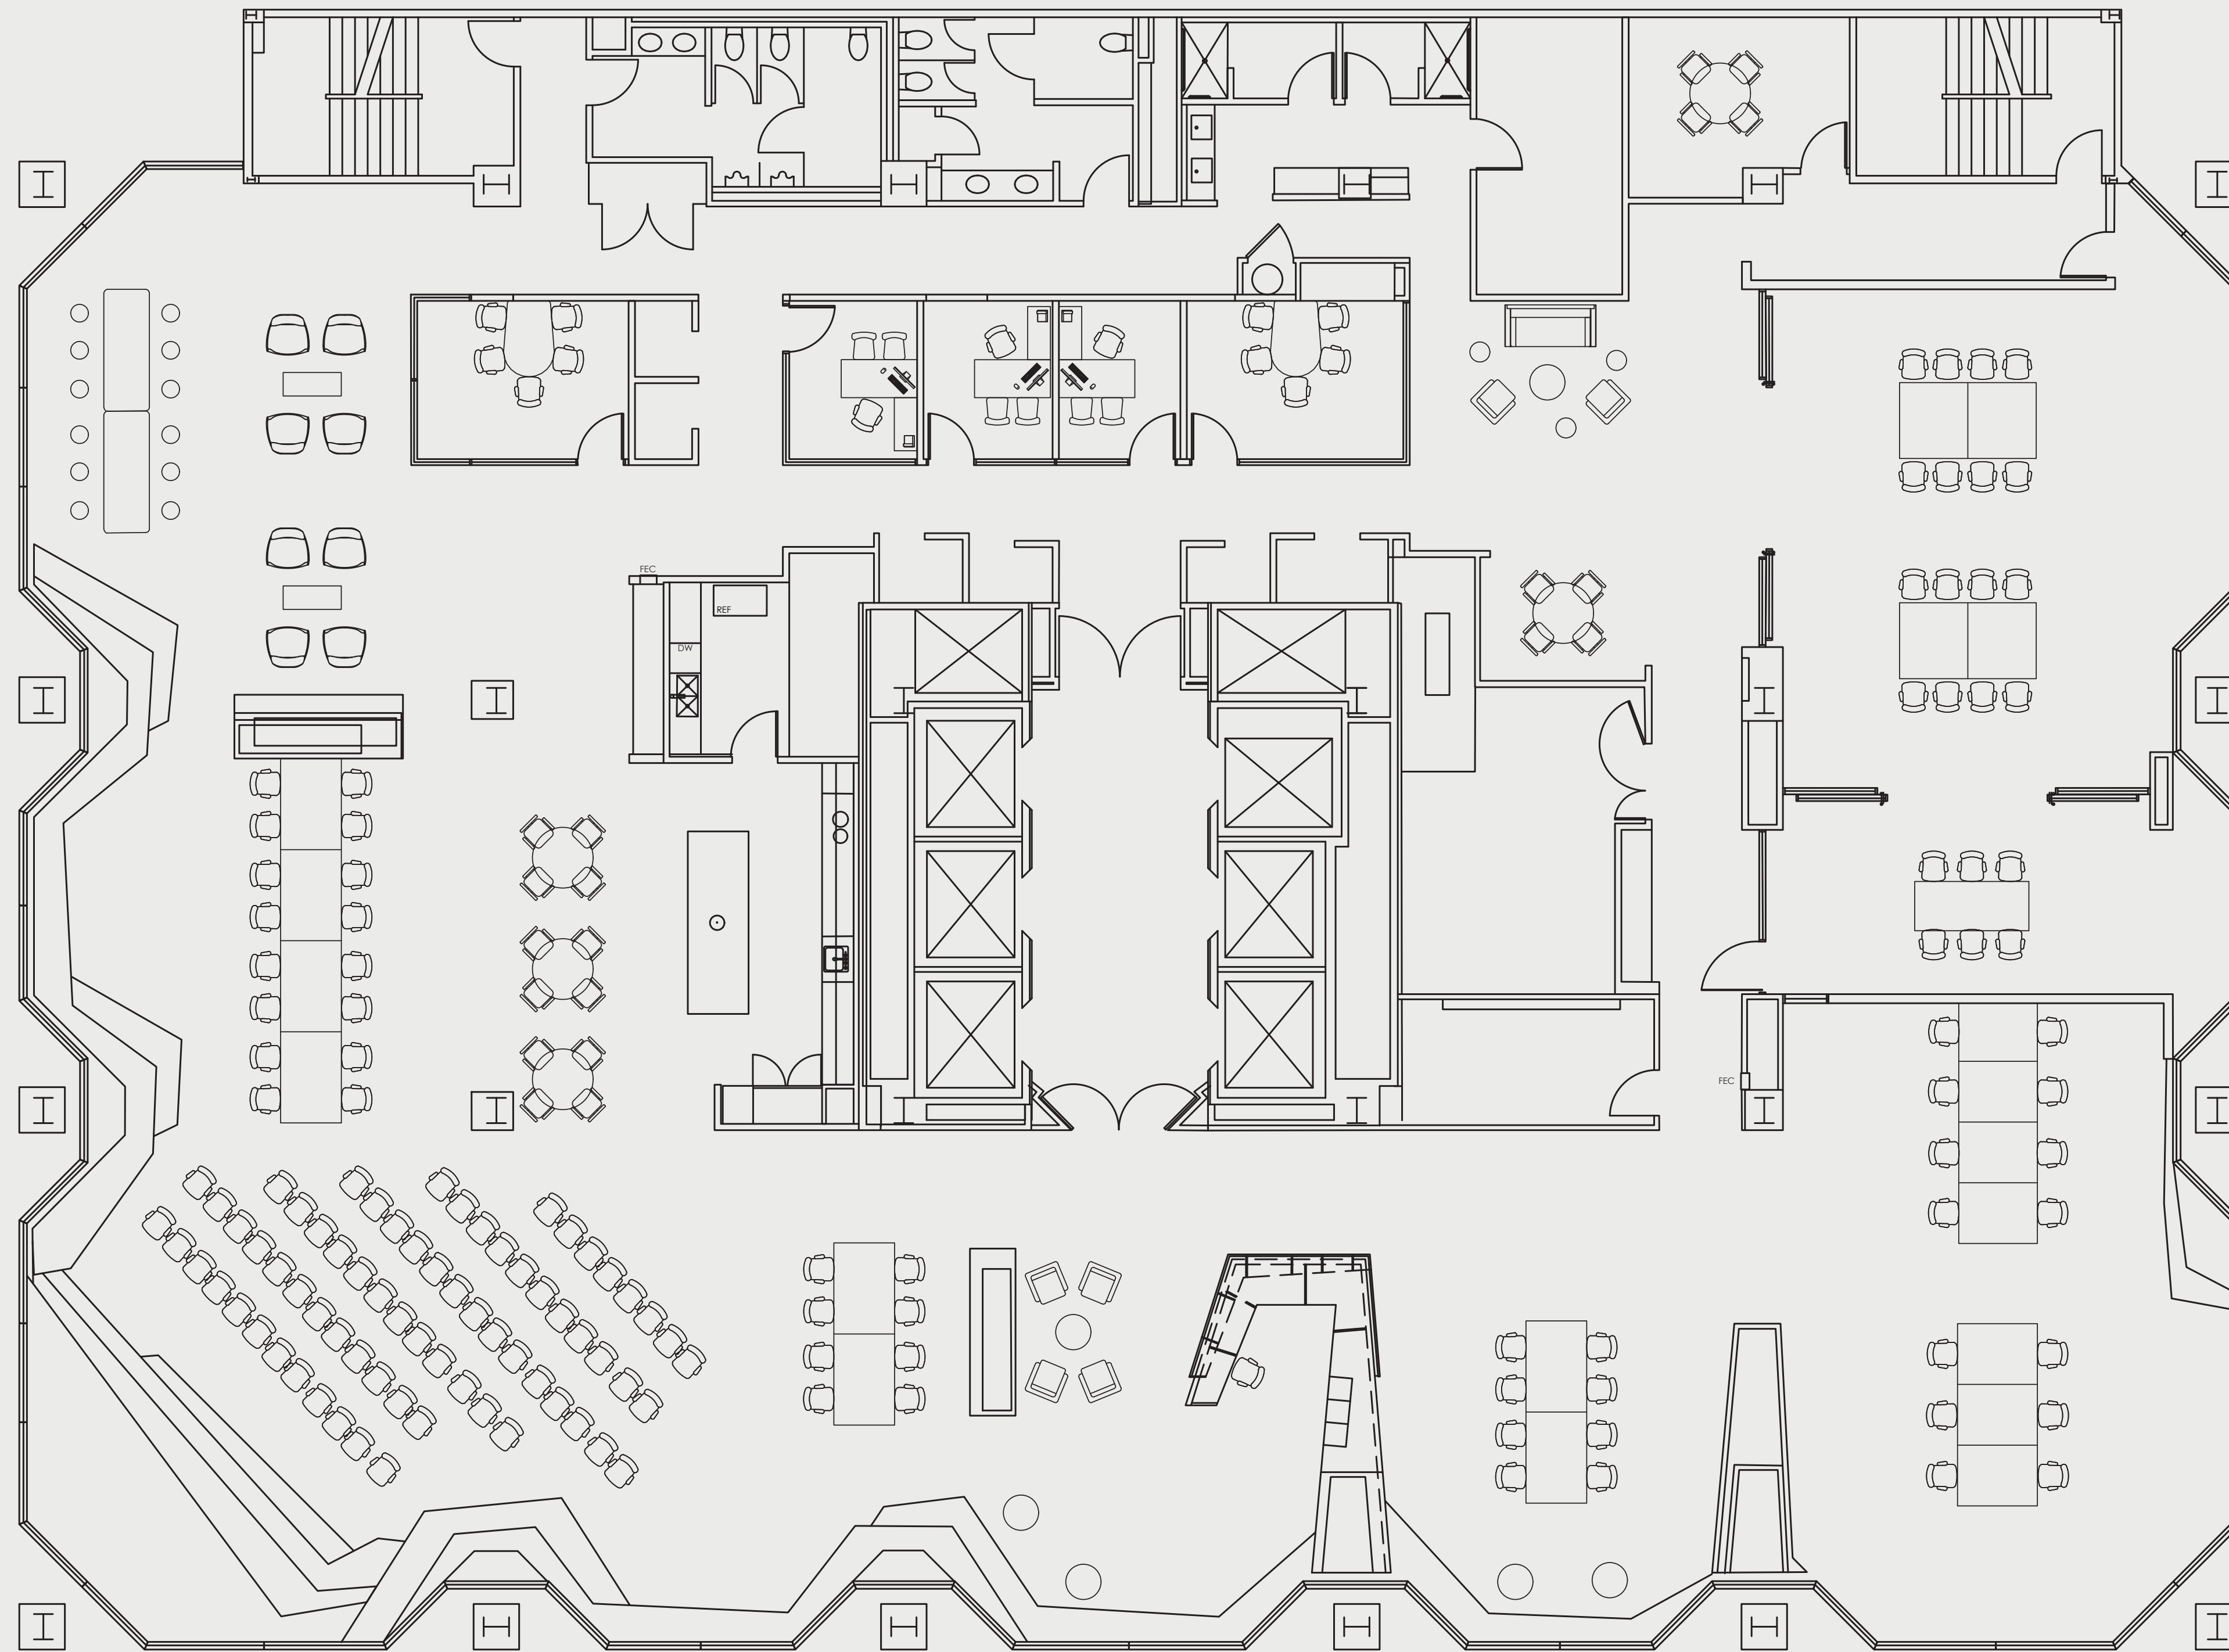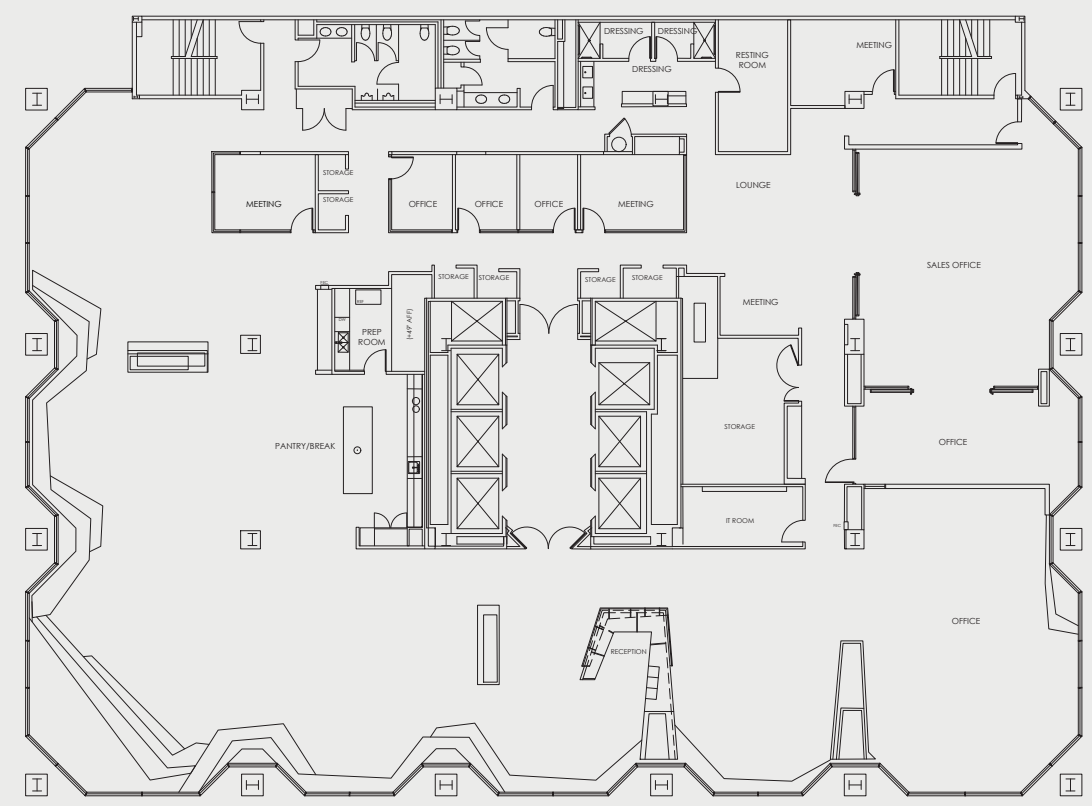

For leasing information please contact:

Nico Vilgate  
213.532.3236 | nico.vilgate@colliers.com

Nick Moscicki  
213.861.3345 | nick.moscicki@colliers.com

