


# SUITE: 410

# RSF: 2,395




## AS-BUILT CONFIGURATION

- OFFICES..... 4
- RECEPTION..... 1
- CONFERENCE ROOMS..... 1
- KITCHEN..... 1
- OPEN WORK AREA..... +/- 6

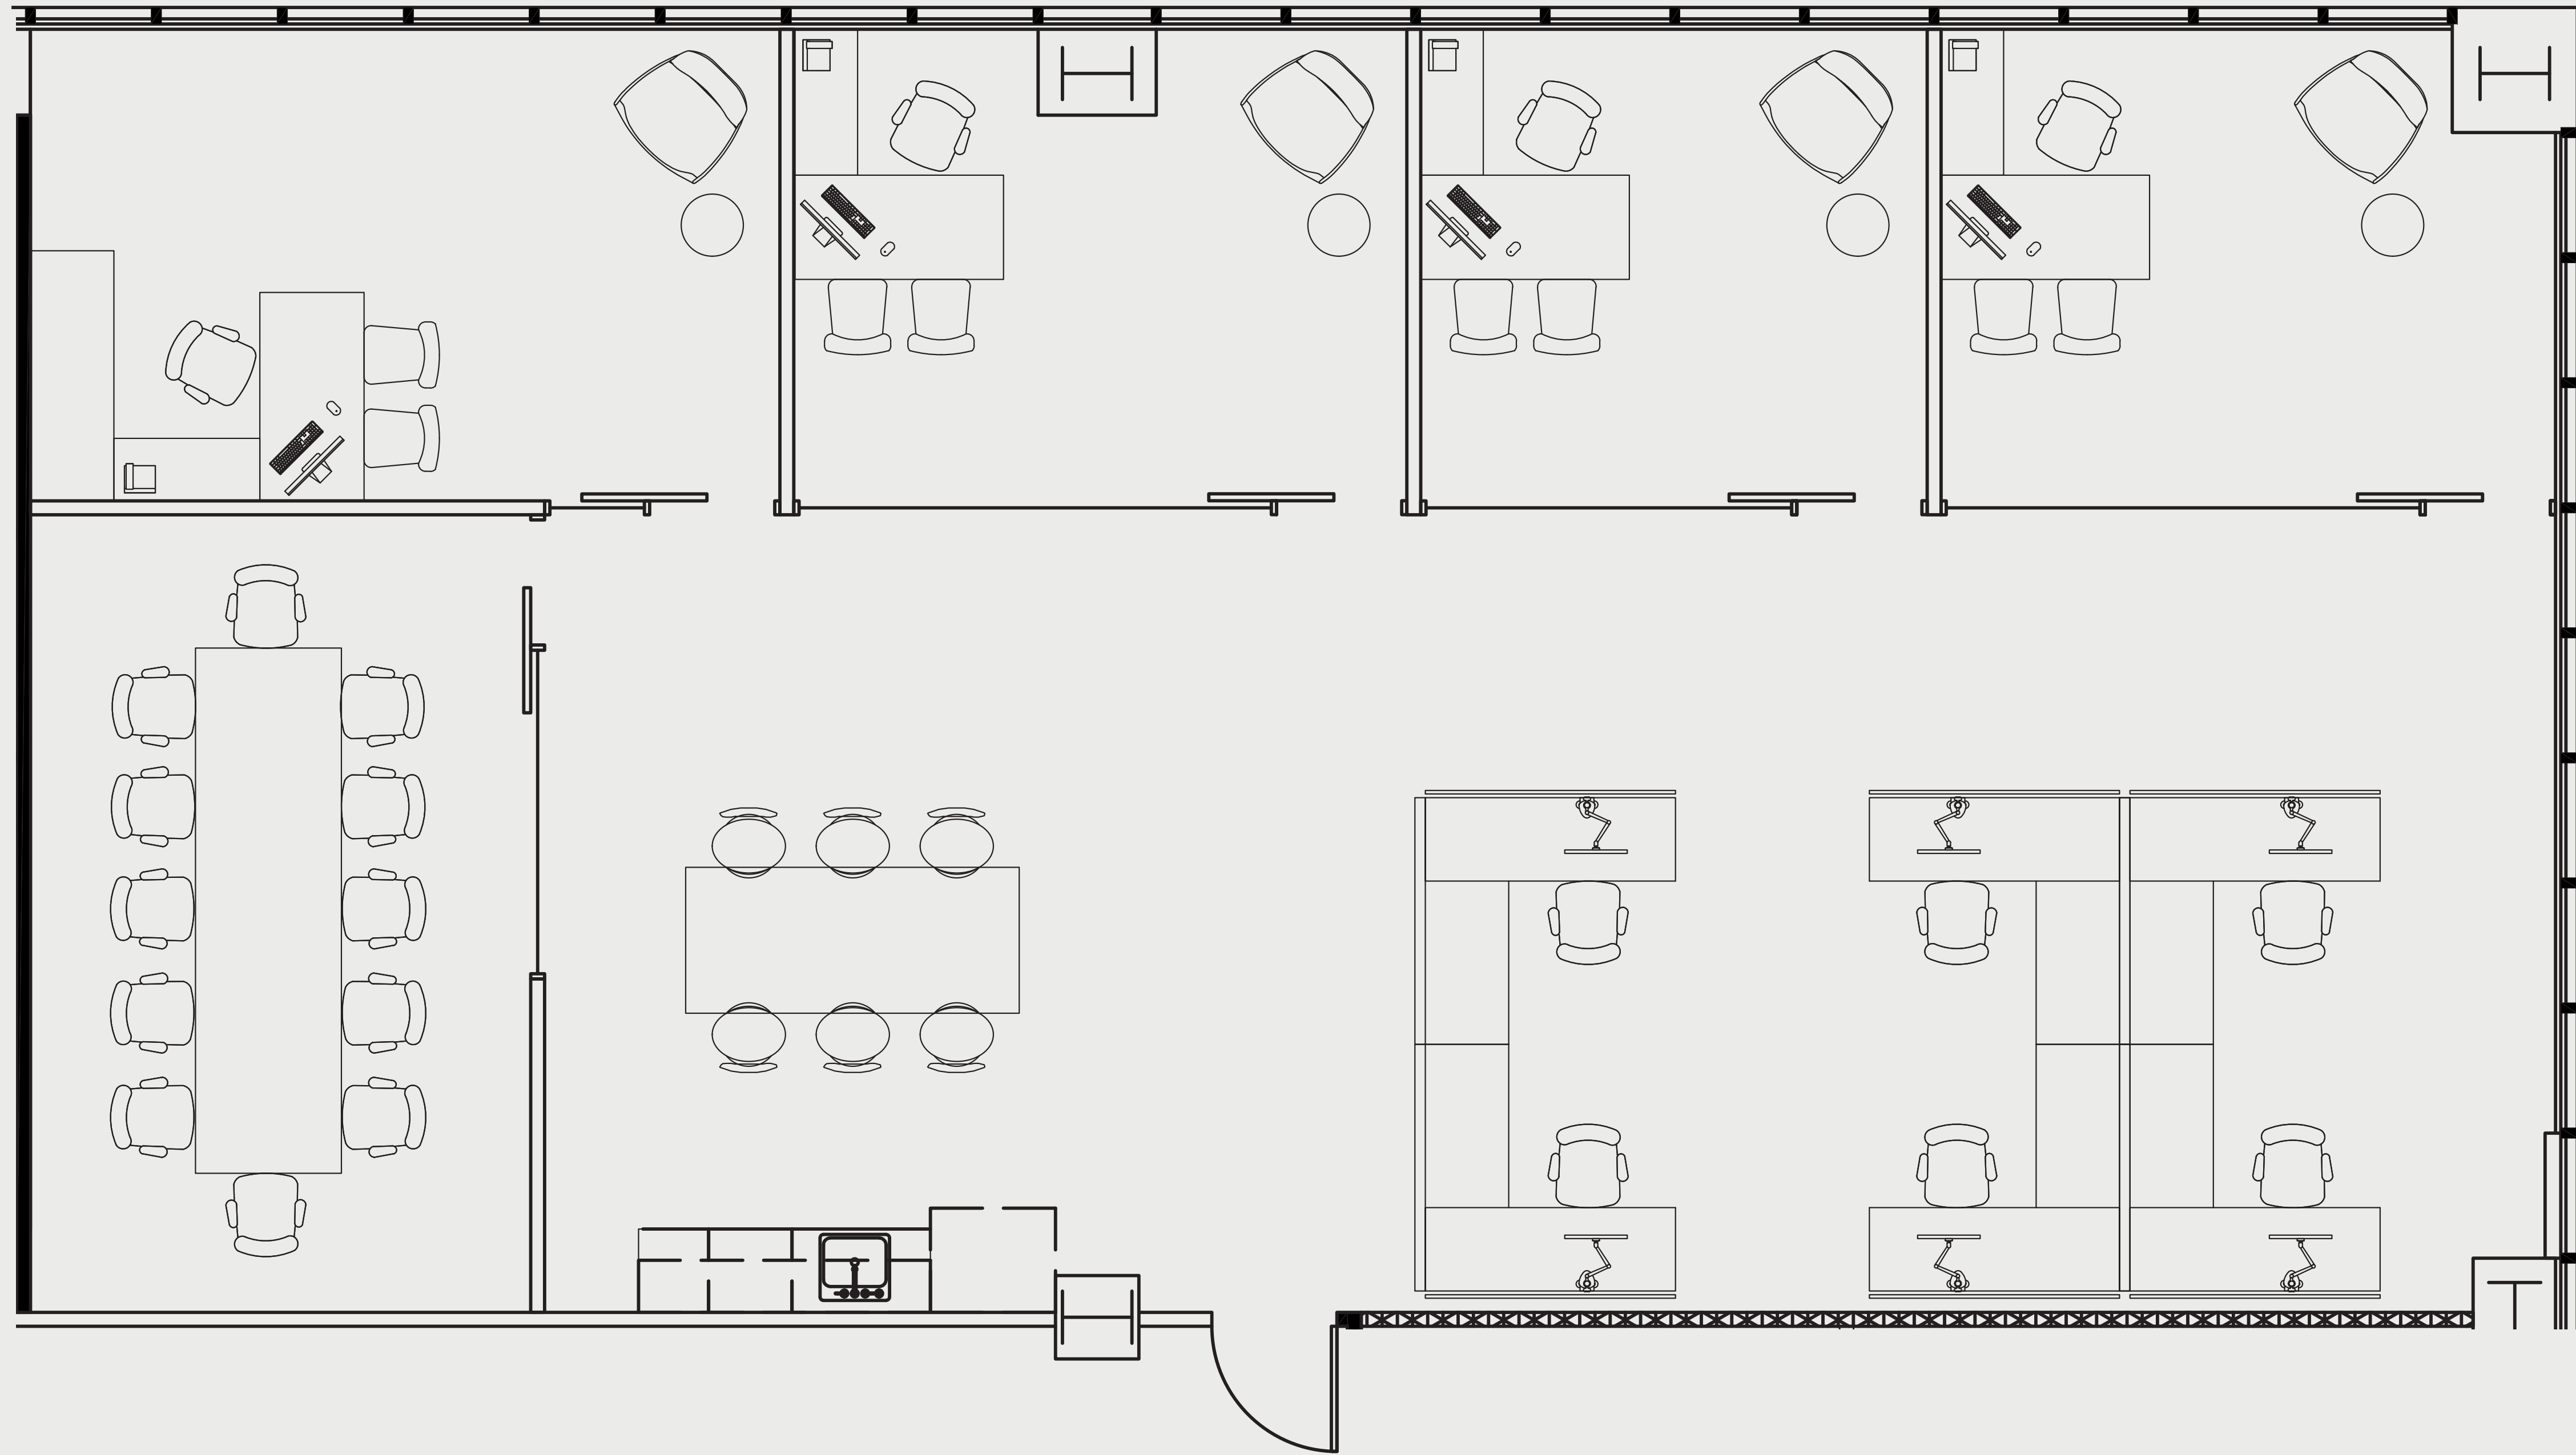

## KEY PLAN:

*Not to scale, furniture and appliances not included*

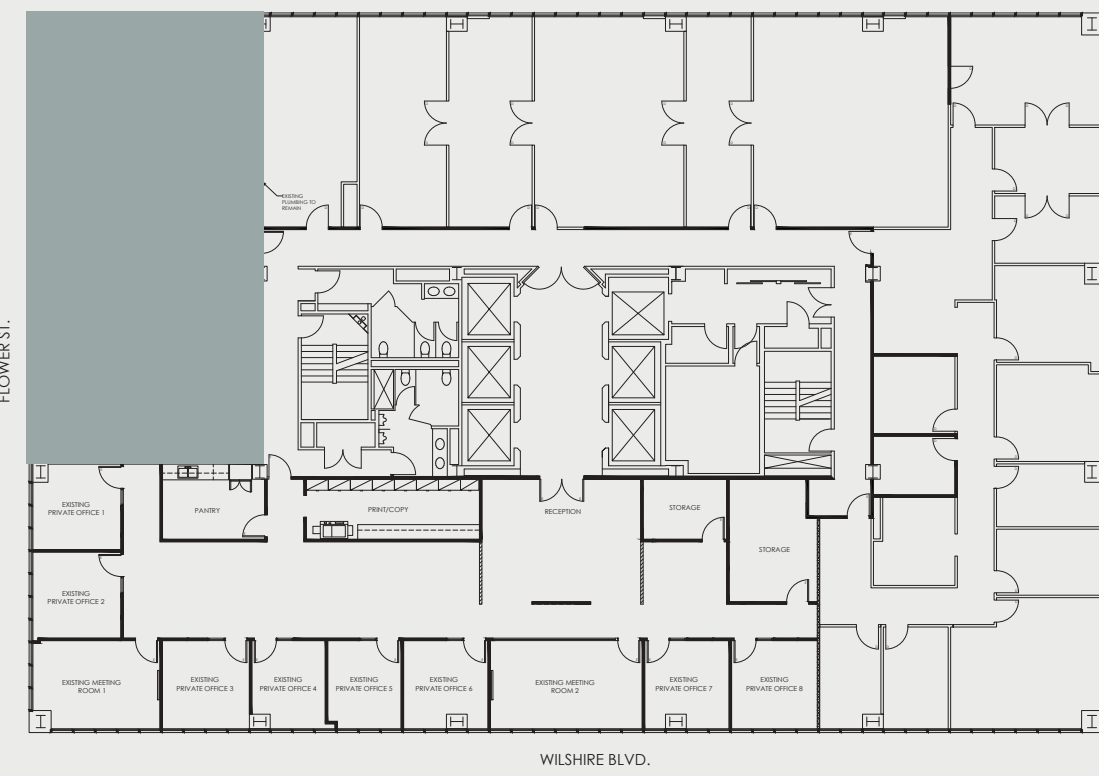

For leasing information please contact:  
Nico Vilgate  
213.532.3236 | nico.vilgate@colliers.com

Nick Moscicki  
213.861.3345 | nick.moscicki@colliers.com

