

SUITE: 450

RSF: 7,203




AS-BUILT CONFIGURATION

- OFFICES..... 9
- RECEPTION..... 1
- CONFERENCE ROOMS..... 9
- KITCHEN..... N/A
- OPEN WORK AREA..... N/A

KEY PLAN:

Not to scale, furniture and appliances not included

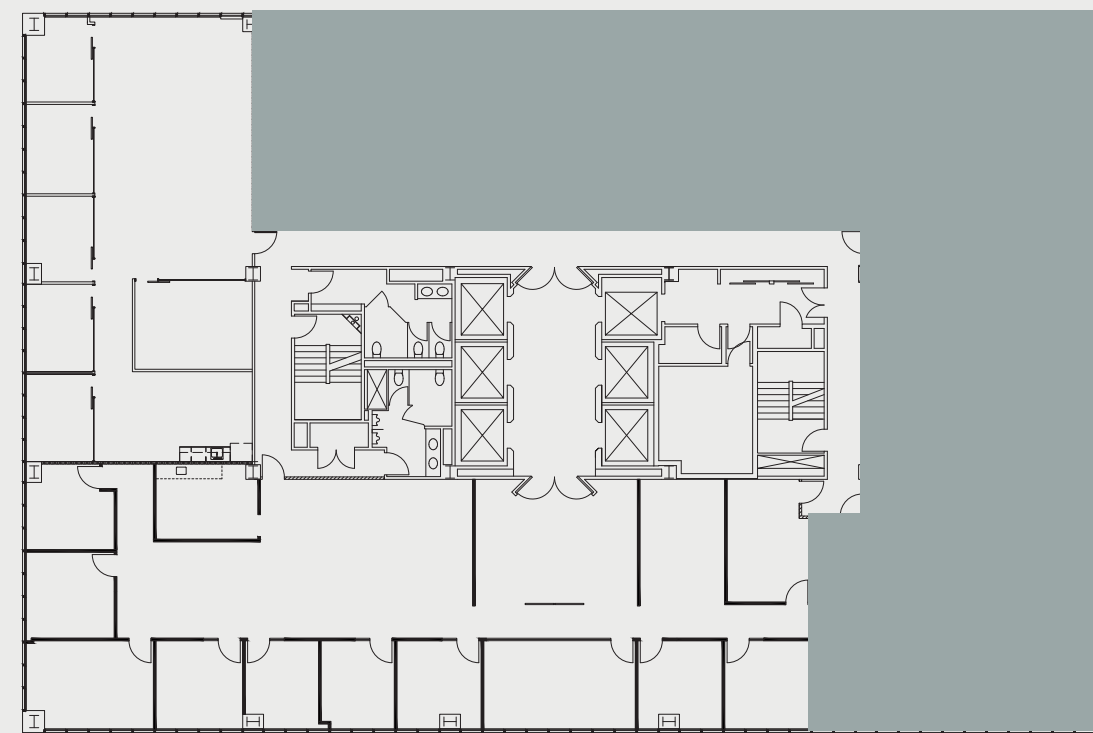

For leasing information please contact:

Nico Vilgate
213.532.3236 | nico.vilgate@colliers.com

Nick Moscicki
213.861.3345 | nick.moscicki@colliers.com

