

SUITE: 750

RSF: 5,748




AS-BUILT CONFIGURATION

- OFFICES..... 6
- CONFERENCE ROOMS..... 2
- HUDDLE ROOMS..... 3
- KITCHEN..... 1
- OPEN WORK AREA..... +/- 28

KEY PLAN:

Not to scale, furniture and appliances not included

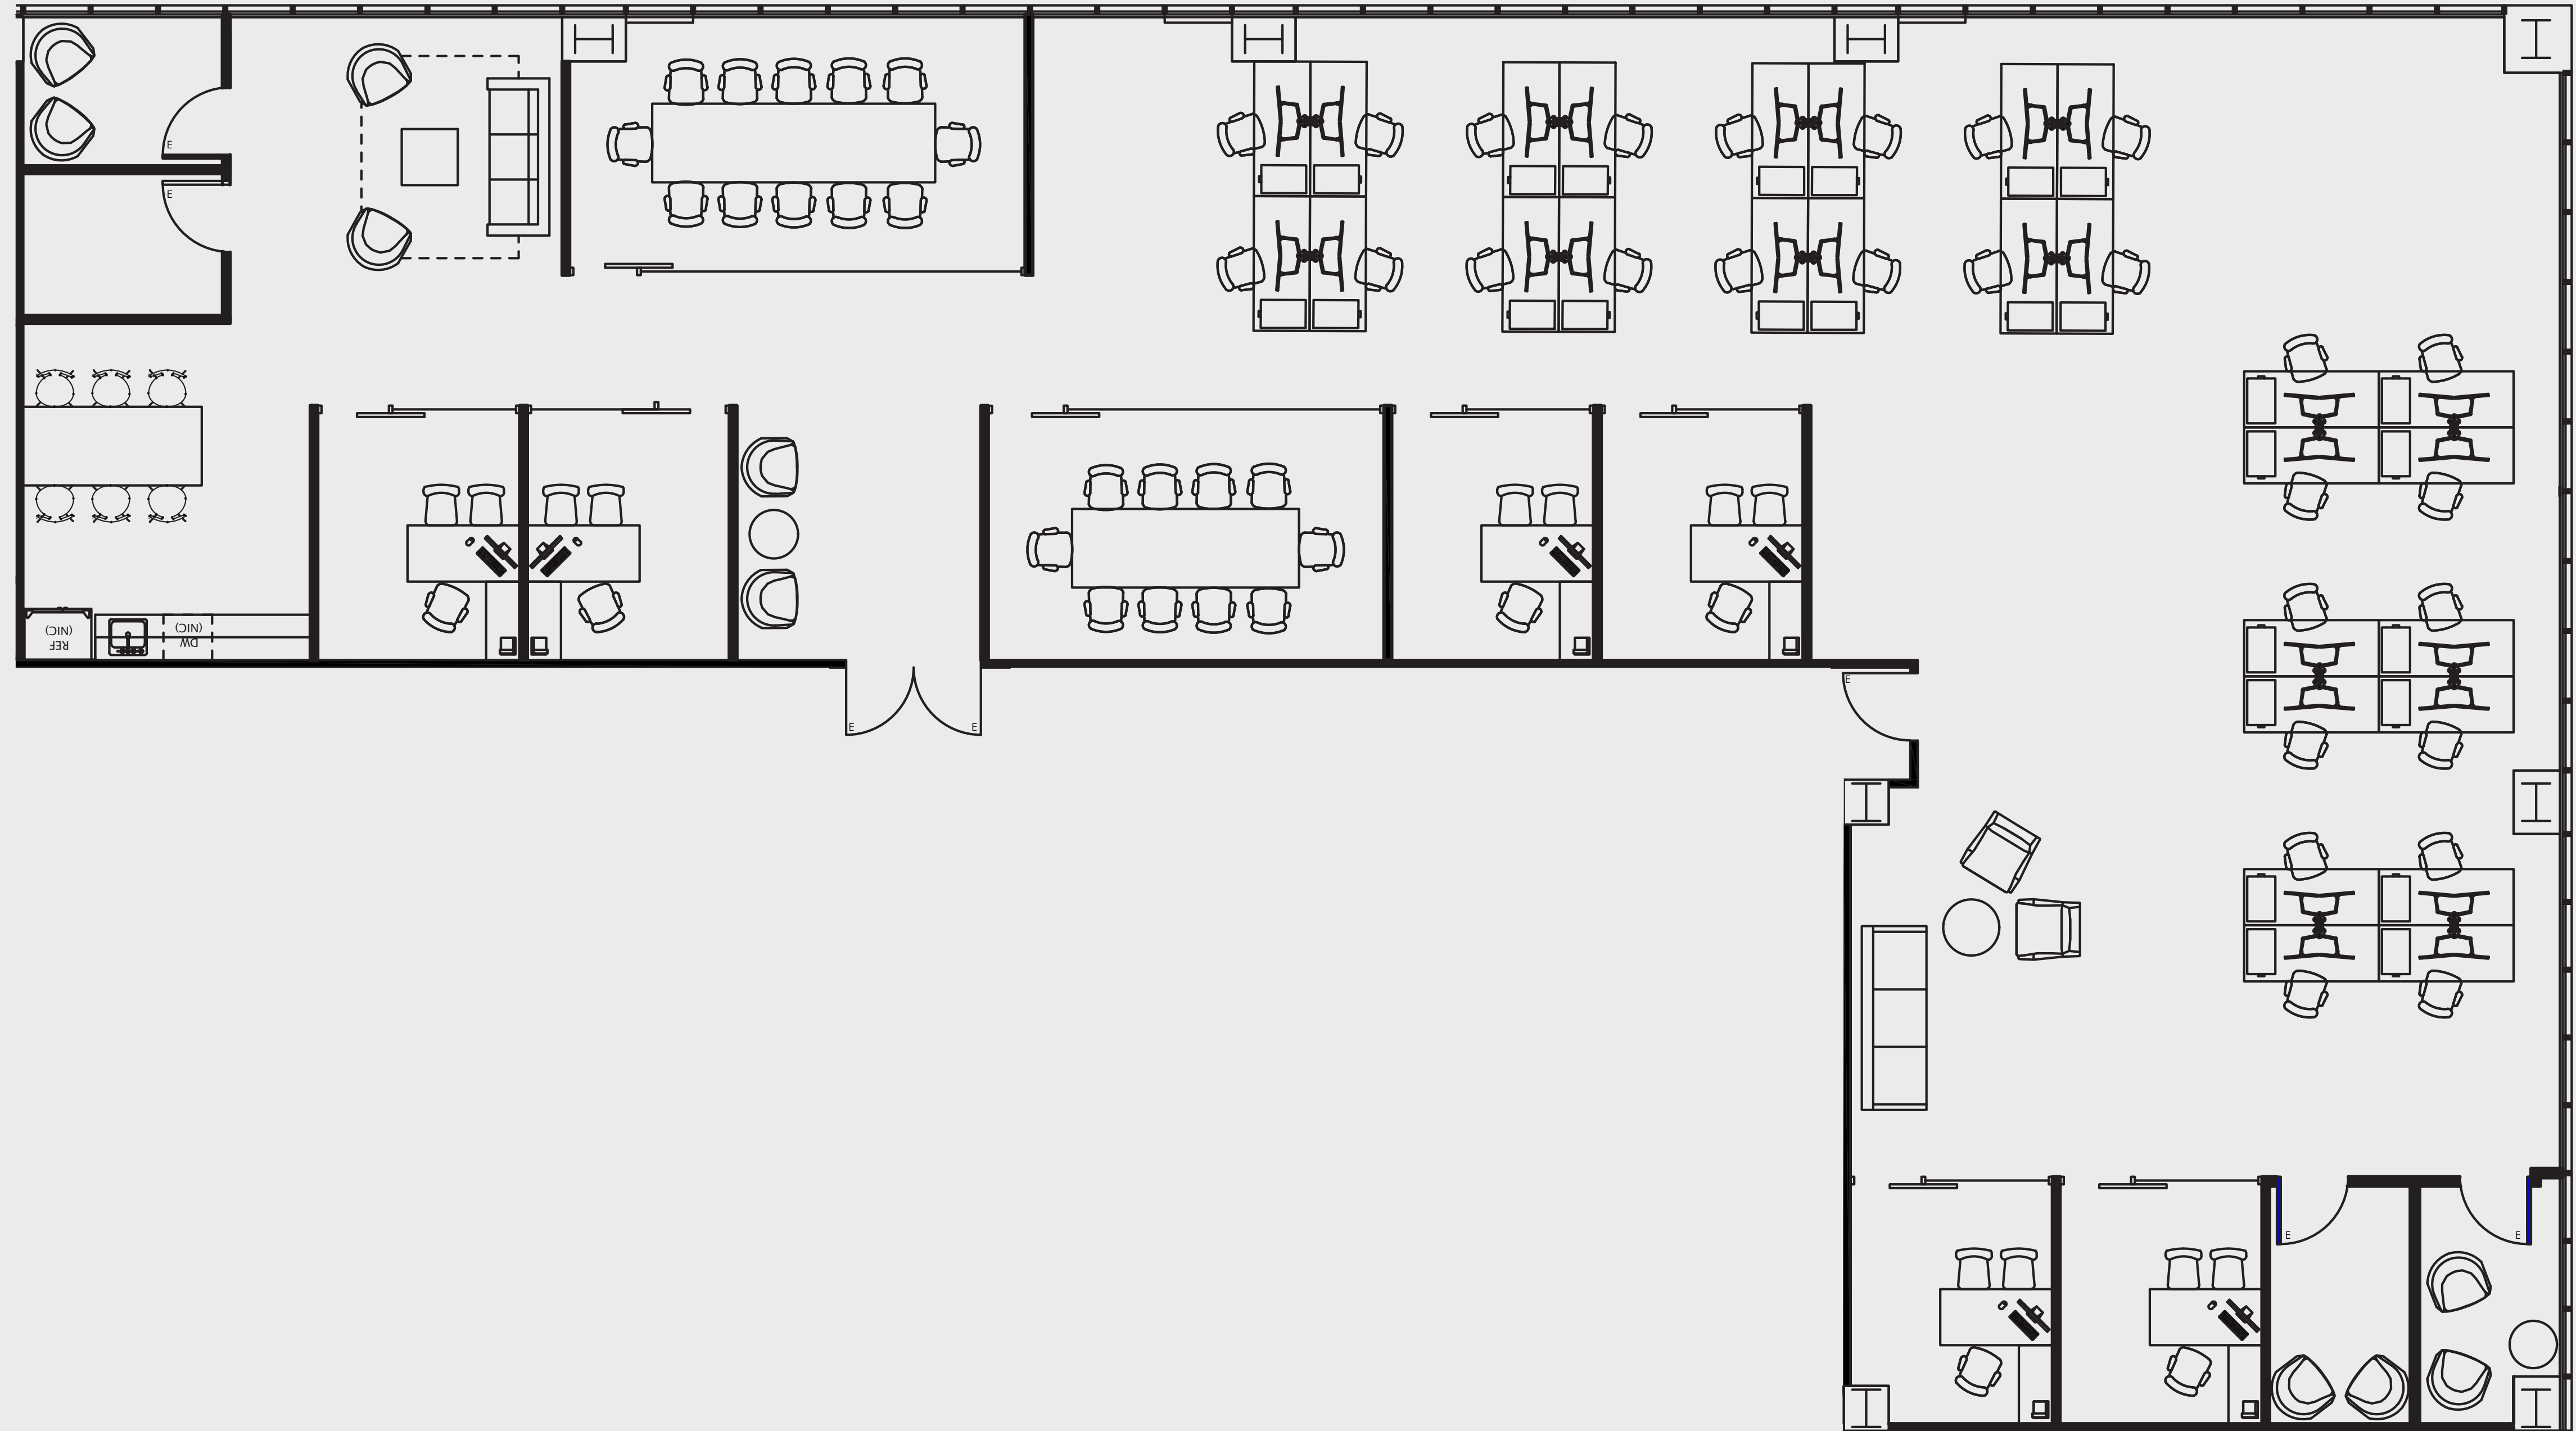

For leasing information please contact:
Nico Vilgate
213.532.3236 | nico.vilgate@colliers.com

Matthew Mazur
213.532.3203 | matthew.mazur@colliers.com

