


SUITE: 808

RSF: 2,446



AS-BUILT CONFIGURATION

- PRIVATE OFFICES..... 2
- CONFERENCE ROOMS..... 1
- KITCHEN..... 1
- OPEN WORK AREA..... +/- 9

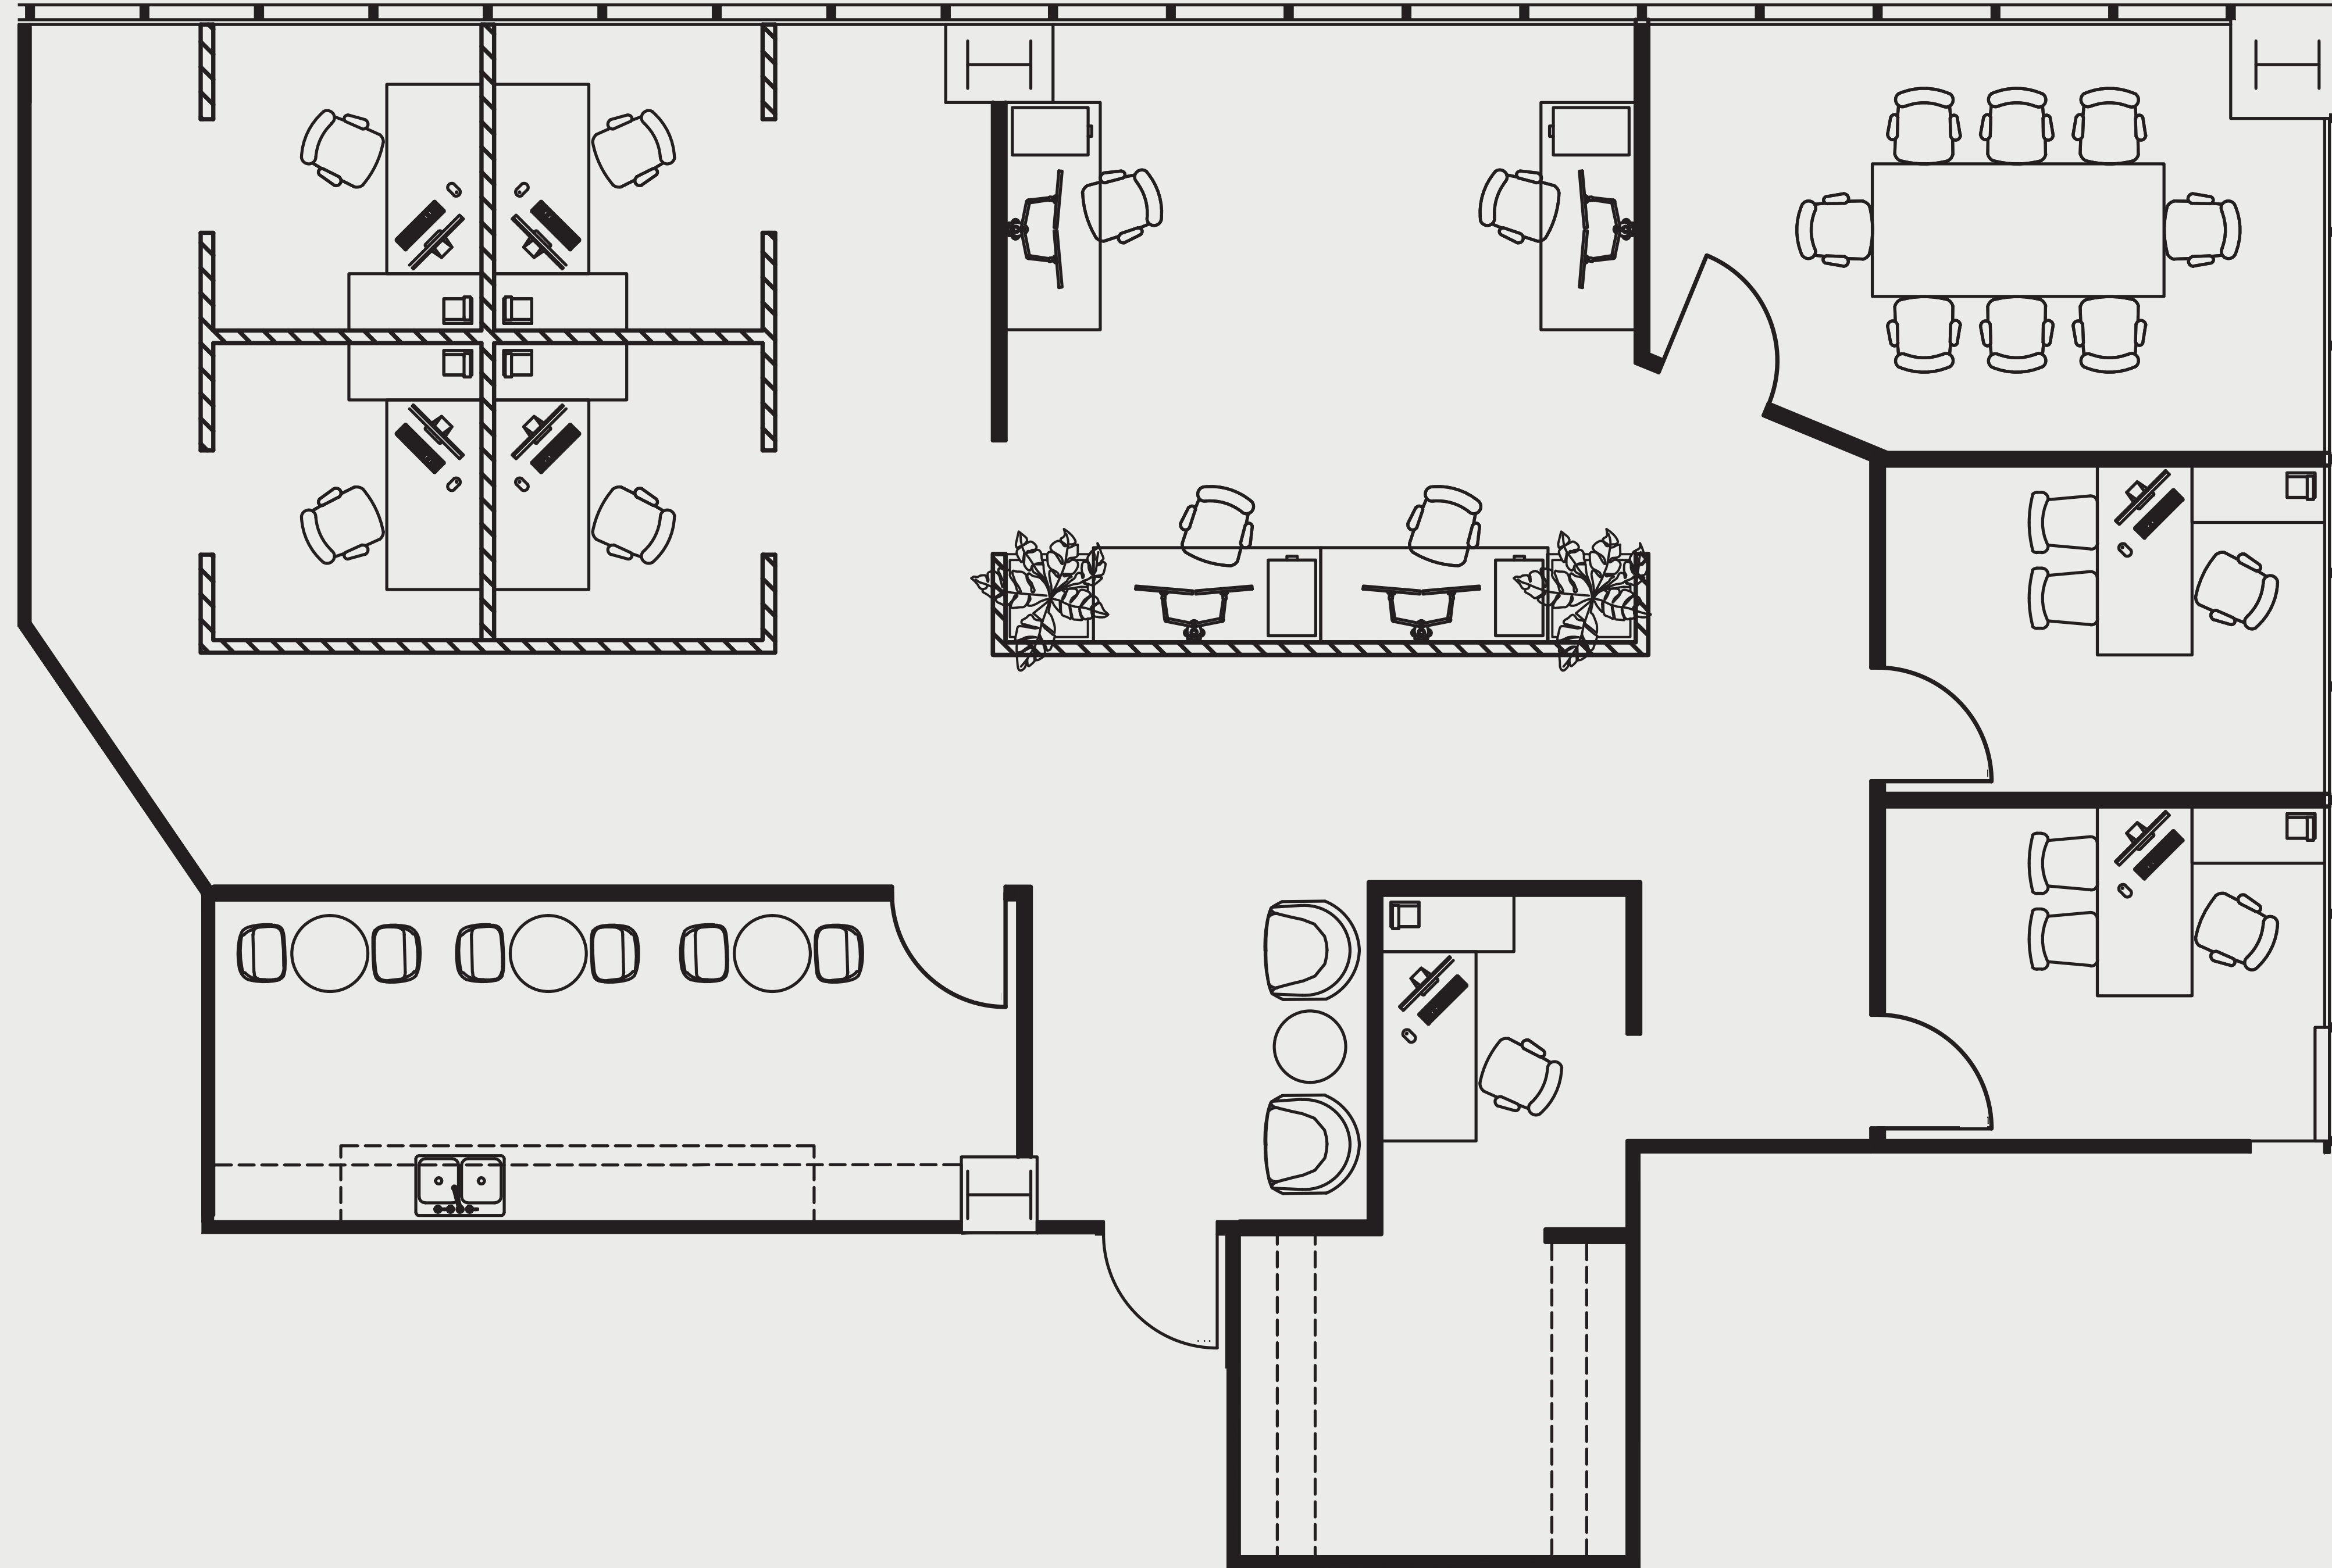

KEY PLAN:

Not to scale, furniture and appliances not included



For leasing information please contact:

Nico Vilgiate
213.532.3236 | nico.vilgiate@colliers.com

Matthew Mazur
213.532.3203. | matthew.mazur@colliers.com

