

SUITE: 900

RSF: 14,418



EIGHTHUNDREDWILSHIRE

AS-BUILT CONFIGURATION

OFFICES.....	24
RECEPTION.....	1
CONFERENCE ROOMS.....	3
KITCHEN.....	2
OPEN WORK AREA.....	+/- 35

Not to scale, furniture and appliances not included

KEY PLAN

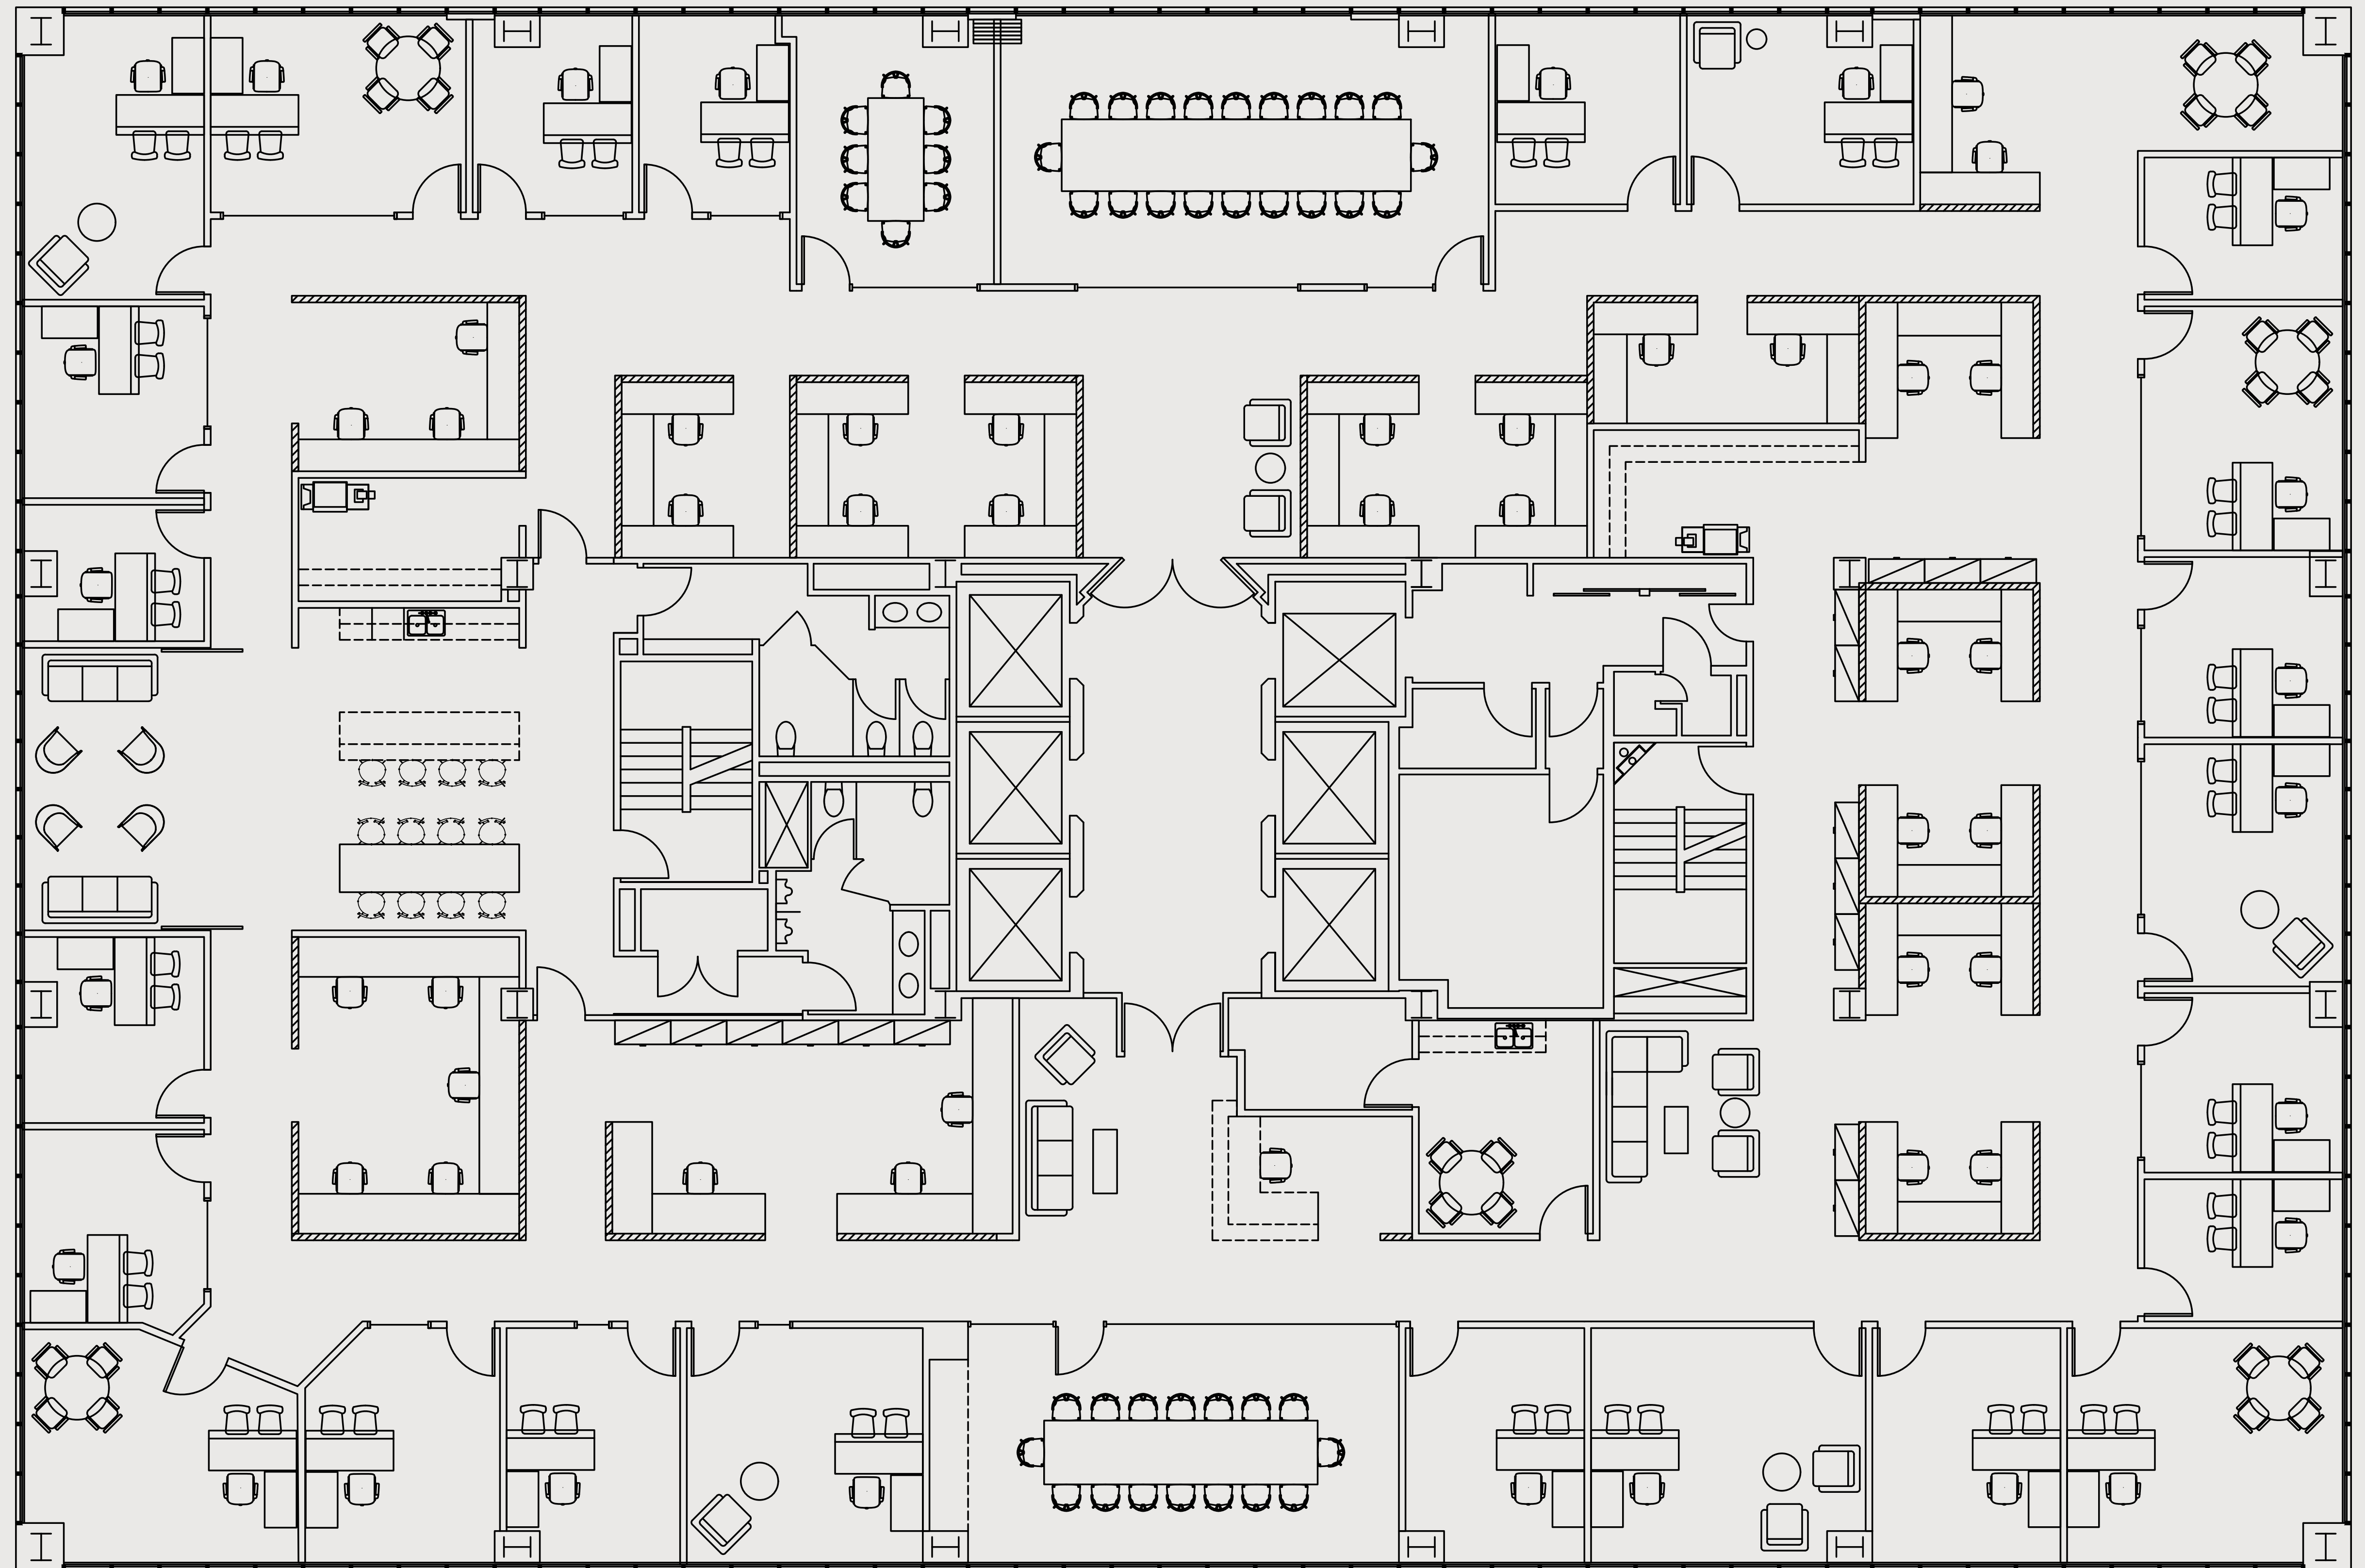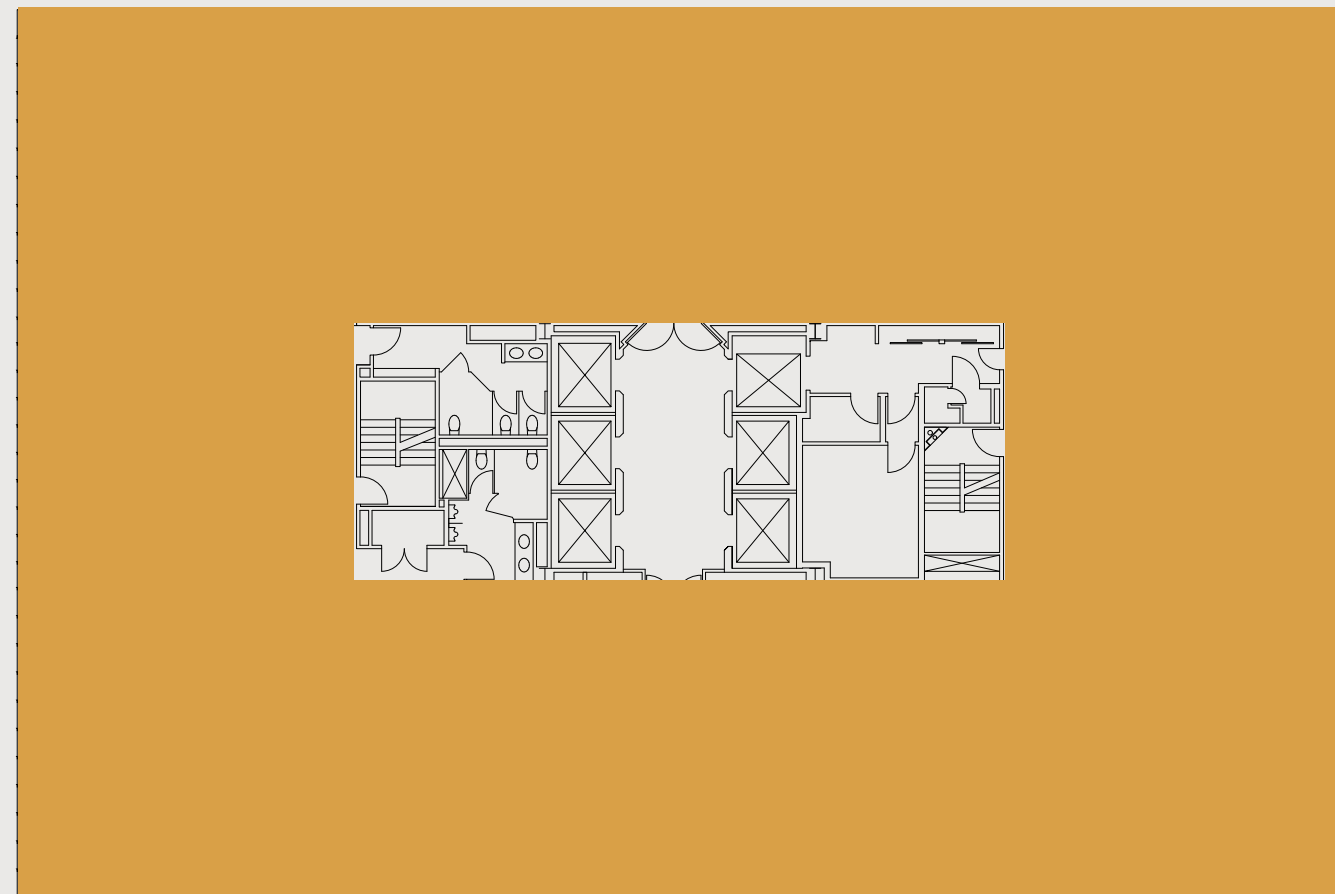

For leasing information please contact:
Andrew Tashjian
213.955.5148 andrew.tashjian@cushwake.com

