# SUITE: 1050 RSF: 3,100

800 WILSHIRE

## AS-BUILT CONFIGURATION

PRIVATE OFFICES..... 3

CONFERENCE ROOMS..... 1

KITCHEN..... 1

OPEN WORK AREA..... +/- 24

RECEPTION..... 1

## KEY PLAN:

*Not to scale, furniture and appliances not included*

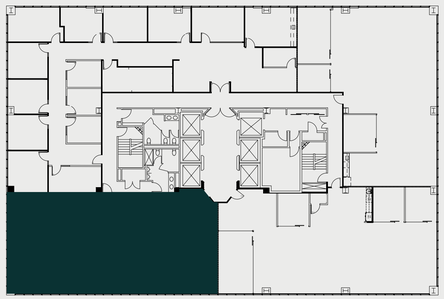

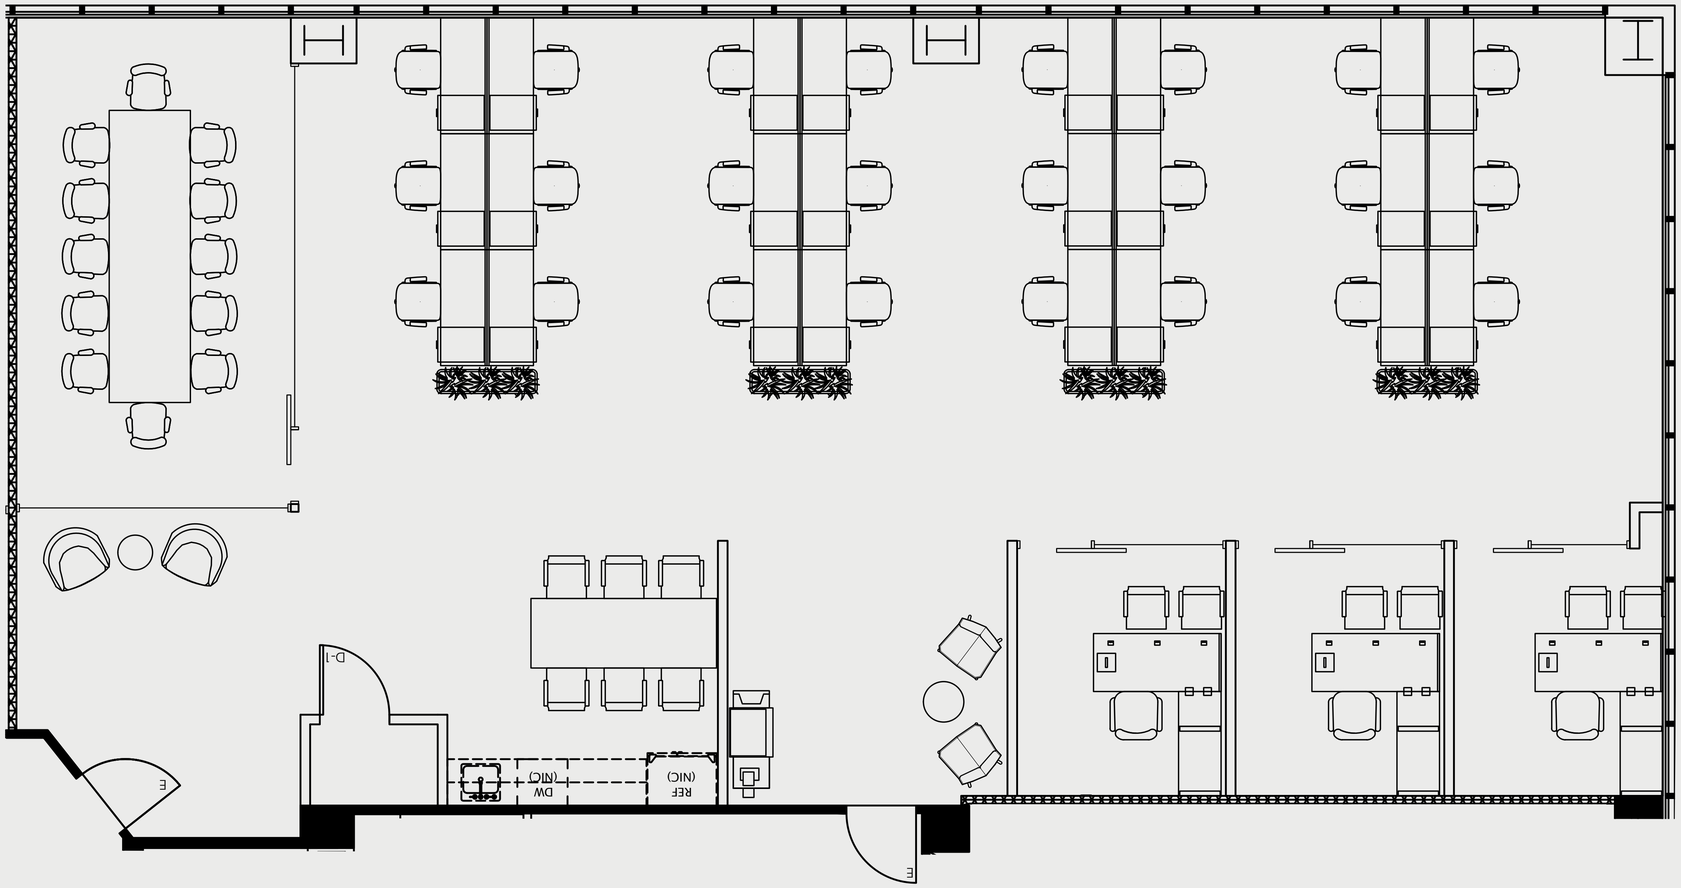


For leasing information please contact:
USALEASING@ONNI.COM
(213) 629-2041

onni group