SUITE: 1525 RSF: 2,127

800 WILSHIRE

AS-BUILT CONFIGURATION

PRIVATE OFFICES.....3


CONFERENCE ROOMS.....1


KITCHEN.....1

OPEN WORK AREA.....+/-14

KEY PLAN:

Not to scale, furniture and appliances not included

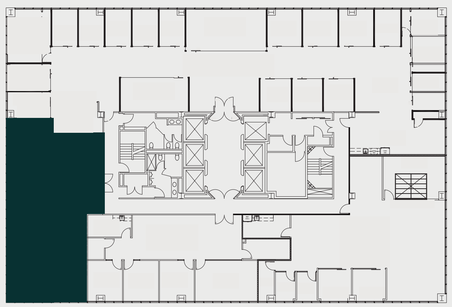

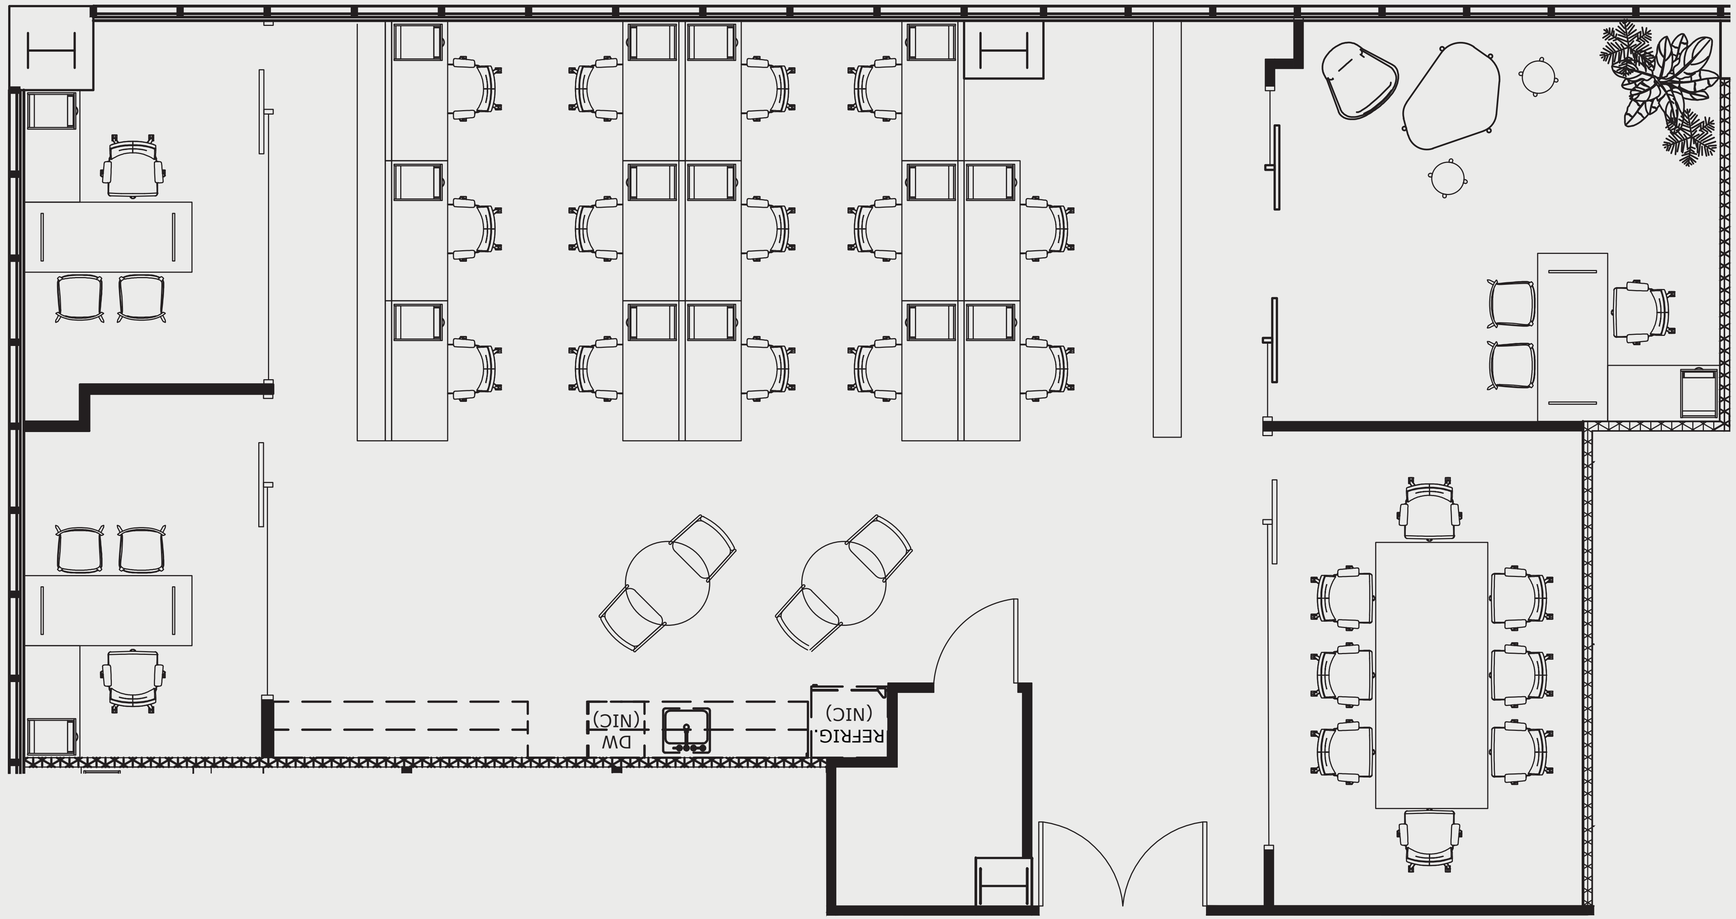

onni group